


USE TYPEWRITER OR BALL POINT PEN-PRESS FIRMLY, PRINT CLEARLY.

WATER WELL RECORD  
KSA 82a-1201-1215

Kansas State Dept. Of Health  
(Water Well Contractors)  
Forbes-Bldg. 740  
Topeka, Kansas 66620

1 Location of well:	County	Township name	Fraction	Section number	Town number	Range number
	POTT	ST. GEORGE NE 1/4 SW 1/4		4	10	9

Distance and direction from nearest town or city:	3 Owner of well:
2 MILES NORTH	MICHAEL R. CRUBEL
Street address of well location if in city:	Address:
OF ST. GEORGE	RR1 ST. GEORGE, KS.

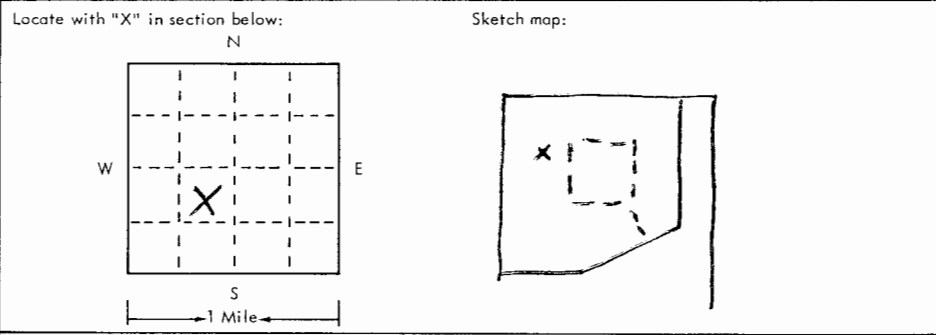

4 Well depth: 64 ft. Date of completion 5/3/15  
Well diameter 10 in.

5  Cable tool  Rotary  Driven  Dug  
 Hollow rod  Jetted  Bored  Reverse rotary

6 Use:  Domestic  Public supply  Industry  
 Irrigation  Air conditioning  Commercial  
 Test well

7 Casing: Material PVC Height: above/below  
Threaded  Welded  Surface 1 1/2 in.  
Diam. \_\_\_\_\_ Weight 200 lbs./ft. \_\_\_\_\_  
5 in. to 64 ft. depth Drive shoe?  Yes  No  
\_\_\_\_\_ in. to \_\_\_\_\_ ft. depth

2 Type and color of material	From	To
BLACK DIRT	0	10
CLAY	10	15
FINE SAND	15	45
COARSE SAND	45	64
(use a second sheet if needed)		

8 Screen: Manufacturer Western  
Type PVC Dia. 5"  
Slot/gauze 1/4 Length 10'  
Set between 54 ft. and 64 ft.  
Fittings: Gravel pack  Yes  No Size range of material 1/4

9 Static water level: 30 ft. below land surface Date 5-3-15

10 Pumping level below land surfaces:  
30 ft. after 2 hrs. pumping 20 g.p.m.  
\_\_\_\_\_ ft. after \_\_\_\_\_ hrs. pumping \_\_\_\_\_ g.p.m.  
Estimated maximum yield 50 g.p.m.

11 Water sample submitted:  
 Yes  No Date \_\_\_\_\_

12 Well head completion: CAPPED  
 Pitless adapter  Inches above grade

13 Well grouted?  Yes  No  
 Neat cement  Bentonite  \_\_\_\_\_  
Depth: From 40 ft. to 25 ft.

14 Nearest source of possible contamination:  
ft. 1000 Direction EAST Type Septic  
Well disinfected upon completion?  Yes  No

15 Pump:  Not installed  
Manufacturer's name \_\_\_\_\_  
Model number \_\_\_\_\_ HP \_\_\_\_\_ Volts \_\_\_\_\_  
Length of drop pipe \_\_\_\_\_ ft. capacity \_\_\_\_\_ g.p.m.  
Type:  
 Submersible  Turbine  
 Jet  Reciprocating  
 Centrifugal  Other

16 Remarks: elevation \_\_\_\_\_

Topography:  
 Hill  
 Slope  
 Upland  
 Valley

17 Water well contractor's certification:  
This well was drilled under my jurisdiction and this report is true to the best of my knowledge and belief.  
PTJ Well Drilling 267  
Business name License No. \_\_\_\_\_  
Address Box 47, Peage, KS  
Signed Paul Schultz Date 5-20-15  
Authorized representative