


USE TYPEWRITER OR BALL POINT PEN-PRESS FIRMLY, PRINT CLEARLY.

WATER WELL RECORD  
KSA 82a-1201-1215

Kansas State Dept. Of Health  
(Water Well Contractors)  
Forbes-Bldg. 740  
Topeka, Kansas 66620

1 Location of well: County × POTT. Township name × ST. GEORGE × NE 1/4 SW 1/4 × Fraction 4 Section number 4 Town number × 10 Range number × 9

Distance and direction from nearest town or city: 2 MILES NORTH 3 Owner of well: MICHAEL R. CRUBEL  
Street address of well location if in city: OF ST. GEORGE Address: RR 1 ST. GEORGE, KS.

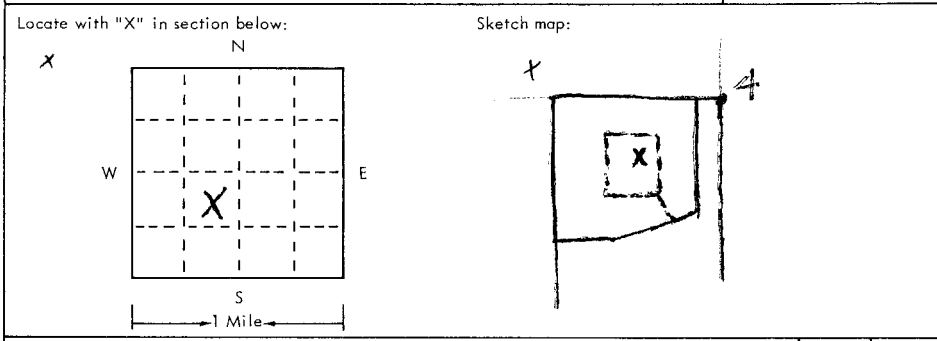

4 Well depth: 90 ft. Date of completion 5-22-75  
Well diameter 10 in.  
5  Cable tool  Rotary  Driven  Dug  
 Hollow rod  Jetted  Bored  Reverse rotary  
6 Use:  Domestic  Public supply  Industry  
 Irrigation  Air conditioning  Commercial  
 Test well  
7 Casing: Material PVC Height: above/below  
Threaded  Welded  Surface 12 in.  
Diam. 5 in. Weight 90 lbs./ft.  
5 in. to 90 ft. depth Drive shoe?  Yes  No  
    in. to     ft. depth

2	Type and color of material	From	To
	<u>Black Dirt</u>	<u>0</u>	<u>20</u>
	<u>Yellow Clay</u>	<u>20</u>	<u>35</u>
	<u>Clay + Fine sand mixed</u>	<u>35</u>	<u>60</u>
	<u>Fine sand</u>	<u>60</u>	<u>75</u>
	<u>Water Bearing sand</u>	<u>75</u>	<u>90</u>

8 Screen: Manufacturer Western  
Type PVC Dia. 5 in.  
Slot/gauze 1/8 in. Length 10 in.  
Set between 20 ft. and 80 ft.  
Fittings: Gravel pack  Yes  No Size range of material 1/4 in.  
9 Static water level: 50 ft. below land surface Date 5-20-75  
10 Pumping level below land surfaces:  
30 ft. after 2 hrs. pumping 20 g.p.m.  
    ft. after     hrs. pumping     g.p.m.  
Estimated maximum yield 25 g.p.m.  
11 Water sample submitted:  Yes  No Date      
12 Well head completion:  Pitless adapter  Inches above grade  
13 Well grouted?  Yes  No  
 Neat cement  Bentonite       
Depth: From 40 ft. to 20 ft.  
14 Nearest source of possible contamination:  
ft. 500 Direction EAST Type Septic  
Well disinfected upon completion?  Yes  No  
15 Pump:  Not installed  
Manufacturer's name Dempster  
Model number     HP 1/2 Volts 220  
Length of drop pipe 80 ft. capacity 20 g.p.m.  
Type:  Submersible  Turbine  
 Jet  Reciprocating  
 Centrifugal  Other

16 Remarks: elevation 1700  
Topography:  Hill  Slope  Upland  Valley  
(use a second sheet if needed)

17 Water well contractor's certification:  
This well was drilled under my jurisdiction and this report is true to the best of my knowledge and belief.  
P+J Well Dig 269  
Business name Becky's Palco, KS License No.      
Address Palco, KS Date 5-24-75  
Signed Palco Authorized representative