


1 Location of well:	County POTT	Township name ST. GEORGE NE 1/4 SW 1/4	Fraction	Section number 4	Town number 10	Range number 9
---------------------	-----------------------	--	----------	----------------------------	--------------------------	--------------------------

Distance and direction from nearest town or city: 2 MILES	3 Owner of well: MICHAEL R. CRUBEL
Street address of well location if in city: NORTH OF ST. GEORGE	Address: RR1 ST. GEORGE, KS.

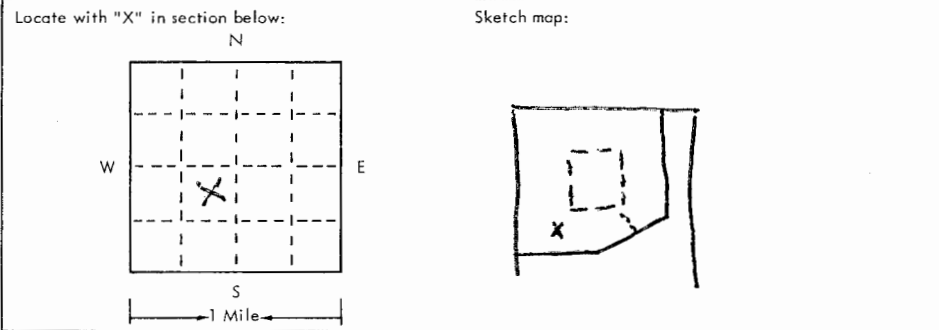

4 Well depth: 60 ft. Date of completion 4-21-75
Well diameter 10 in.

5 Cable tool Rotary Driven Dug
 Hollow rod Jetted Bored Reverse rotary

6 Use: Domestic Public supply Industry
 Irrigation Air conditioning Commercial
 Test well

7 Casing: Material PVC Height: above/below
Threading Welded Surface 12 in.
Diam. 5 in. Weight 200 lbs./ft.
5 in. to 60 ft. depth Drive shoe? Yes No
 in. to ft. depth

2	Type and color of material	From		To	
	Black BLACK Dirt			0	5
	Fine SAND			5	45
	COARSE GRAVEL			45	60
(use a second sheet if needed)					

8 Screen:
Manufacturer Western
Type PVC Dia. 5"
Slot/groove 1/8 Length 10'
Set between 60 ft. and 50 ft.
Fittings:
Gravel pack Yes No Size range of material

9 Static water level:
30 ft. below land surface Date 5-3-75

10 Pumping level below land surfaces:
30 ft. after 2 hrs. pumping 30 g.p.m.
 ft. after hrs. pumping g.p.m.
Estimated maximum yield 50 g.p.m.

11 Water sample submitted:
 Yes No Date

12 Well head completion: Capped
 Pitless adapter Inches above grade

13 Well grouted? Yes No
 Neat cement Bentonite
Depth: From 30 ft. to 15 ft.

14 Nearest source of possible contamination:
ft. 150 Direction West Type Creek
Well disinfected upon completion? Yes No

15 Pump: Not installed
Manufacturer's name
Model number HP Volts
Length of drop pipe ft. capacity g.m.p.
Type:
 Submersible Turbine
 Jet Reciprocating
 Centrifugal Other

16 Remarks: elevation 1050'

Topography:
 Hill
 Slope
 Upland
 Valley

17 Water well contractor's certification:
This well was drilled under my jurisdiction and this report is true to the best of my knowledge and belief.
Pot Well Driller 209
Business name License No.
Address Ben 42 Dodge, KS
Signed Paul ... Date 5-29-75
Authorized representative