


LOCATION OF WATER WELL: Pottawatomie County: **Pottawatomie**
 Fraction: **NW 1/4 NW 1/4 N W 1/4** Section Number: **4** Township Number: **T 10 S** Range Number: **R 9**

Distance and direction from nearest town or city street address of well if located within city?
2 & 1/2 North Of St George Kansas

WATER WELL OWNER: **Virlin Fleming**
 R.R. #, St. Address, Box #: **R.R.**
 City, State, ZIP Code: **St George, Kansas 66535**
 Board of Agriculture, Division of Water Resources
 Application Number:

LOCATE WELL'S LOCATION WITH AN "X" IN SECTION BOX: **4** DEPTH OF COMPLETED WELL: **138** ft. ELEVATION: _____
 Depth(s) Groundwater Encountered: **66** ft. 2. _____ ft. 3. _____ ft.

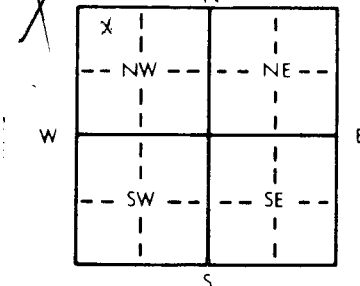

WELL'S STATIC WATER LEVEL: **66** ft. below land surface measured on **mo/day/yr 4-29-1985**
 Pump test data: Well water was _____ ft. after _____ hours pumping _____ gpm
 Est. Yield: **40** gpm; Well water was _____ ft. after _____ hours pumping _____ gpm
 Bore Hole Diameter: **13 1/2** in. to **138** ft., and _____ in. to _____ ft.
 WELL WATER TO BE USED AS:
 1 Domestic 2 Irrigation 3 Feedlot 4 Industrial 5 Public water supply 6 Oil field water supply 7 Lawn and garden only 8 Air conditioning 9 Dewatering 10 Observation well 11 Injection well 12 Other (Specify below)
 Was a chemical/bacteriological sample submitted to Department? Yes _____ No ; If yes, mo/day/yr sample was submitted _____
 Water Well Disinfected? Yes No

TYPE OF BLANK CASING USED:
 1 Steel 2 PVC 3 RMP (SR) 4 ABS 5 Wrought iron 6 Asbestos-Cement 7 Fiberglass 8 Concrete tile 9 Other (specify below) _____
 CASING JOINTS: Glued Clamped _____ Welded _____ Threaded _____
 Blank casing diameter: **5** in. to **98** ft., Dia _____ in. to _____ ft., Dia _____ in. to _____ ft.
 Casing height above land surface: **24** in., weight **200** lbs./ft. Wall thickness or gauge No. **200**

TYPE OF SCREEN OR PERFORATION MATERIAL:
 1 Steel 2 Brass 3 Stainless steel 4 Galvanized steel 5 Fiberglass 6 Concrete tile 7 PVC 8 RMP (SR) 9 ABS 10 Asbestos-cement 11 Other (specify) _____ 12 None used (open hole)
 SCREEN OR PERFORATION OPENINGS ARE:
 1 Continuous slot 2 Louvered shutter 3 Mill slot 4 Key punched 5 Gauzed wrapped 6 Wire wrapped 7 Torch cut 8 Saw cut 9 Drilled holes 10 Other (specify) _____ 11 None (open hole)

SCREEN-PERFORATED INTERVALS: From **98** ft. to **135** ft., From _____ ft. to _____ ft., From _____ ft. to _____ ft.
 GRAVEL PACK INTERVALS: From **50** ft. to **138** ft., From _____ ft. to _____ ft., From _____ ft. to _____ ft.

GROUT MATERIAL: 1 Neat cement 2 Cement grout 3 Bentonite 4 Other _____
 Grout Intervals: From _____ ft. to _____ ft., From **0** ft. to **20** ft., From _____ ft. to _____ ft.

What is the nearest source of possible contamination:
 1 Septic tank 2 Sewer lines 3 Watertight sewer lines 4 Lateral lines 5 Cess pool 6 Seepage pit 7 Pit privy 8 Sewage lagoon 9 Feedyard 10 Livestock pens 11 Fuel storage 12 Fertilizer storage 13 Insecticide storage 14 Abandoned water well 15 Oil well/Gas well 16 Other (specify below) _____

Direction from well? **SE** How many feet? **100**

FROM	TO	LITHOLOGIC LOG	FROM	TO	LITHOLOGIC LOG
0	2	Sandy			
2	35	Brown sand			
35	70	Fine white sand			
70	80	Very fine sand			
80	105	White fine sand			
105	120	Fine sand			
120	138	Very fine sand			

CONTRACTOR'S OR LANDOWNER'S CERTIFICATION: This water well was (1) constructed, (2) reconstructed, or (3) plugged under my jurisdiction and was completed on (mo/day/year) **4-29-1985** and this record is true to the best of my knowledge and belief. Kansas Water Well Contractor's License No. **234** d. This Water Well Record was completed on (mo/day/yr) **4-29-1985**
 Under the business name of **Blue Valley Drilling** by (signature) **Berard Strader**

INSTRUCTIONS: Use typewriter or ball point pen, PLEASE PRESS FIRMLY and PRINT clearly. Please fill in blanks, underline or circle the correct answers. Send triplicate copies to Kansas Department of Health and Environment, Division of Environment, Environmental Geology Section, Topeka, KS 66620. Send one to WATER WELL OWNER and retain one for your records.