


LOCATION OF WATER WELL: County: POTT Fraction: NW 1/4 NW 1/4 SE 1/4 Section Number: 4 Township Number: T 10 S Range Number: R 9 EW

Distance and direction from nearest town or city street address of well if located within city? From Manhattan Go 6 miles East on 24<sup>th</sup> then Go 1/4 mile North + 1/4 East

WATER WELL OWNER: Stan Smith  
 RR#, St. Address, Box #: RR  
 City, State, ZIP Code: St George, KS 66535  
 Board of Agriculture, Division of Water Resources  
 Application Number:

LOCATE WELL'S LOCATION WITH AN "X" IN SECTION BOX:

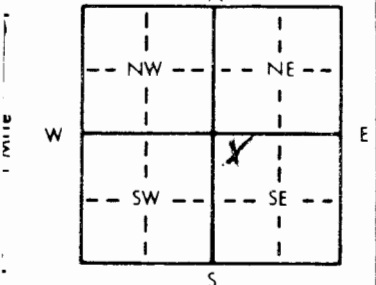

DEPTH OF COMPLETED WELL: 100 ft. ELEVATION:

Depth(s) Groundwater Encountered: 1. 65 ft. 2. ft. 3. ft.

WELL'S STATIC WATER LEVEL: 60 ft. below land surface measured on mo/day/yr

Pump test data: Well water was ft. after hours pumping gpm

Est. Yield: 20 gpm: Well water was ft. after hours pumping gpm

Bore Hole Diameter: 10 in. to 100 ft., and in. to

WELL WATER TO BE USED AS:

1 Domestic 3 Feedlot 6 Oil field water supply 9 Dewatering 12 Other (Specify below)

2 Irrigation 4 Industrial 7 Lawn and garden only 10 Monitoring well

Was a chemical/bacteriological sample submitted to Department? Yes No: If yes, mo/day/yr sample was submitted

Water Well Disinfected? Yes No

TYPE OF BLANK CASING USED:

1 Steel 3 RMP (SR) 5 Wrought iron 8 Concrete tile CASING JOINTS: Glued Clamped

2 PVC 4 ABS 6 Asbestos-Cement 9 Other (specify below) Welded

Blank casing diameter: 5 in. to 80 ft., Dia. in. to ft., Dia. in. to

Casing height above land surface: 2' in., weight Sch 40 lbs./ft. Wall thickness or gauge No.

TYPE OF SCREEN OR PERFORATION MATERIAL:

1 Steel 3 Stainless steel 5 Fiberglass 8 RMP (SR) 11 Other (specify)

2 Brass 4 Galvanized steel 6 Concrete tile 9 ABS 12 None used (open hole)

SCREEN OR PERFORATION OPENINGS ARE:

1 Continuous slot 3 Mill slot 12/1000's 5 Gauzed wrapped 8 Saw cut 11 None (open hole)

2 Louvered shutter 4 Key punched 7 Torch cut 10 Other (specify)

SCREEN-PERFORATED INTERVALS:

From: 80 ft. to 100 ft., From ft. to ft.

GRAVEL PACK INTERVALS:

From: 25 ft. to 100 ft., From ft. to ft.

GROUT MATERIAL:

1 Neat cement 2 Cement grout 3 Bentonite 4 Other

Grout Intervals: From: 0 ft. to 25 ft., From ft. to ft.

What is the nearest source of possible contamination:

1 Septic tank 4 Lateral lines 7 Pit privy 10 Livestock pens 14 Abandoned water well

2 Sewer lines 5 Cess pool 8 Sewage lagoon 11 Fuel storage 15 Oil well/Gas well

3 Watertight sewer lines 6 Seepage pit 9 Feedyard 12 Fertilizer storage 16 Other (specify below)

Direction from well?

FROM	TO	LITHOLOGIC LOG	FROM	TO	PLUGGING INTERVALS
0	65	Sandy CLAY			
65	85	Fine Sand (Water)			
85	99	Medium Sand			
99	100	Bedrock			

CONTRACTOR'S OR LANDOWNER'S CERTIFICATION: This water well was (1) constructed, (2) reconstructed, or (3) plugged under my jurisdiction and was completed on (mo/day/year) 7/27/92 and this record is true to the best of my knowledge and belief. Kansas

Water Well Contractor's License No. 451 This Water Well Record was completed on (mo/day/yr) 8/16/92

under the business name of Holderson Well Drilling by (signature) Wayne Cuppe