


1] LOCATION OF WATER WELL: County: Pottawatomie Fraction: SE 1/4 NW 1/4 NW 1/4 Section Number: 5 Township Number: T 10 S Range Number: R 9 E/W

Distance and direction from nearest town or city street address of well if located within city?

1 1/2 west, 1 1/2 north of St. George

2] WATER WELL OWNER: Carl Meyer
 RR#, St. Address, Box # :
 City, State, ZIP Code : St. George, KS 66535
 Board of Agriculture, Division of Water Resources
 Application Number:

3] LOCATE WELL'S LOCATION WITH AN "X" IN SECTION BOX:

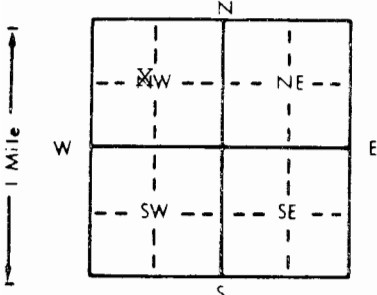

4] DEPTH OF COMPLETED WELL: 172 ft. ELEVATION:
 Depth(s) Groundwater Encountered 1. ft. 2. ft. 3. ft.
 WELL'S STATIC WATER LEVEL 86 ft. below land surface measured on mo/day/yr 7-18-90
 Pump test data: Well water was ft. after hours pumping gpm
 Est. Yield 45 gpm: Well water was ft. after hours pumping gpm
 Bore Hole Diameter: 12" in. to ft., and in. to ft.
 WELL WATER TO BE USED AS:
1 Domestic 3 Feedlot 6 Oil field water supply 9 Dewatering 12 Other (Specify below)
2 Irrigation 4 Industrial 7 Lawn and garden only 10 Monitoring well
 Was a chemical/bacteriological sample submitted to Department? Yes No X; If yes, mo/day/yr sample was submitted
 Water Well Disinfected? Yes X No

5] TYPE OF BLANK CASING USED:
 1 Steel 3 RMP (SR) 5 Wrought iron 8 Concrete tile CASING JOINTS: Glued X Clamped
 2 PVC 4 ABS 6 Asbestos-Cement 9 Other (specify below) Welded
 7 Fiberglass Threaded

Blank casing diameter 5" in. to 0-156 ft. Dia 5" in. to 171-172' ft. Dia
 Casing height above land surface 24" in. weight 2.82 lbs./ft. Wall thickness or gauge No. 258

TYPE OF SCREEN OR PERFORATION MATERIAL:
 1 Steel 3 Stainless steel 5 Fiberglass 7 PVC 10 Asbestos-cement
 2 Brass 4 Galvanized steel 6 Concrete tile 8 RMP (SR) 11 Other (specify)
 9 ABS 12 None used (open hole)

SCREEN OR PERFORATION OPENINGS ARE:
 1 Continuous slot 3 Mill slot 5 Gauzed wrapped 8 Saw cut 11 None (open hole)
 2 Louvered shutter 4 Key punched 6 Wire wrapped 9 Drilled holes
 7 Torch cut 10 Other (specify)

SCREEN-PERFORATED INTERVALS: From 156 ft. to 171 ft. From ft. to ft.
 From ft. to ft. From ft. to ft.
 GRAVEL PACK INTERVALS: From 24 ft. to 172' ft. From ft. to ft.
 From ft. to ft. From ft. to ft.

6] GROUT MATERIAL: 1 Neat cement 2 Cement grout 3 Bentonite 4 Otherhole plug
 Grout Intervals: From 4 ft. to 24 ft. From ft. to ft. From ft. to ft.

What is the nearest source of possible contamination:
 1 Septic tank 4 Lateral lines 7 Pit privy 10 Livestock pens 14 Abandoned water well
 2 Sewer lines 5 Cess pool 8 Sewage lagoon 11 Fuel storage 15 Oil well/Gas well
 3 Watertight sewer lines 6 Seepage pit 9 Feedyard 12 Fertilizer storage 16 Other (specify below)
 13 Insecticide storage

Direction from well? north How many feet? 145'

FROM	TO	LITHOLOGIC LOG	FROM	TO	PLUGGING INTERVALS
0	12	Silty Clay-Brown	169	170	Fine Sand-Coarse Sand-Med-Pea Cher
12	18	Fine Sand-Brown-Silty	170	180	Shale-Grey
18	25	Clay-Brown-Silty			
25	35	Fine Sand-Brown			
35	47	Clay-Brown-Silty			
47	52	Fine Sand-Brown-Silty			
52	56	Clay-Brown-Silty			
56	77	Fine Sand-Brown			
77	84	Clay-Brown			
84	90	Fine Sand-Brown			
90	94	Clay-Brown			
94	101	Fine Sand-Brown			
101	115	Clay-Brown-Silty			
115	127	Fine Sand-Brown-Silty			
127	169	Fine Sand-Brown			

7] CONTRACTOR'S OR LANDOWNER'S CERTIFICATION: This water well was (1) constructed, (2) reconstructed, or (3) plugged under my jurisdiction and was completed on (mo/day/year) 7-18-90 and this record is true to the best of my knowledge and belief. Kansas
 Water Well Contractor's License No. 182 This Water Well Record was completed on (mo/day/yr) 7-27-90
 under the business name of STRADER DRILLING CO., INC. by (signature) Dale Osborn