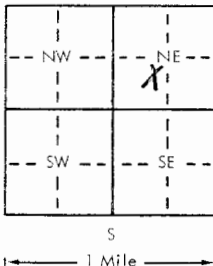
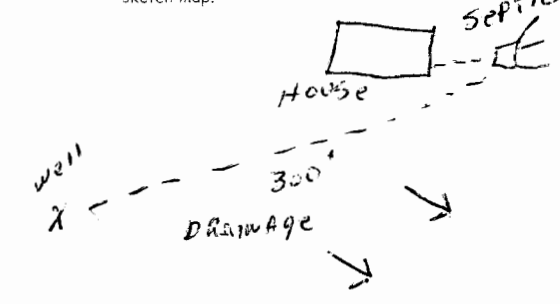


USE TYPEWRITER OR BALL POINT PEN-PRESS FIRMLY, PRINT CLEARLY.

WATER WELL RECORD  
KSA 82a-1201-1215

Kansas Department of Health and Environment-Division of Environment (Water well Contractors) Topeka, Kansas 66620

1. Location of well:		County <b>POTTAWATOMIE</b>	Fraction <b>SW 1/4 SW 1/4 NE 1/4</b>	Section number <b>6</b>	Township number <b>T 10 S</b>	Range number <b>R 9 E</b>
2. Distance and direction from nearest town or city: <b>1.1 W 1/2 N</b>			3. Owner of well: <b>CARL MEYER</b>			
Street address of well location if in city: <b>OF ST. GEORGE</b>			R.R. or street: City, state, zip code: <b>RR # ST. GEORGE, KS 66535</b>			
4. Locate with "X" in section below:		Sketch map:		6. Bore hole dia. <b>12</b> in. Completion date _____ Well depth <b>122</b> ft. <b>12-6-78</b>		
				7. Cable tool <input checked="" type="checkbox"/> Rotary <input type="checkbox"/> Driven <input type="checkbox"/> Dug <input type="checkbox"/> Hollow rod <input type="checkbox"/> Jetted <input type="checkbox"/> Bored <input type="checkbox"/> Reverse rotary		
5. Type and color of material				8. Use: <input checked="" type="checkbox"/> Domestic <input type="checkbox"/> Public supply <input type="checkbox"/> Industry <input type="checkbox"/> Irrigation <input type="checkbox"/> Air conditioning <input type="checkbox"/> Stock <input type="checkbox"/> Lawn <input type="checkbox"/> Oil field water <input type="checkbox"/> Other		
				9. Casing: Material <b>PVC</b> Height: <b>Above</b> or below Threaded <input type="checkbox"/> Welded <input type="checkbox"/> Surface <b>29</b> in. RMP _____ PVC <b>9L</b> Weight <b>255</b> lbs./ft. Dia. <b>4</b> in. to <b>122</b> ft. depth Wall Thickness: inches or Dia. _____ in. to _____ ft. depth Gage No. <b>279</b>		
				10. Screen: Manufacturer's name _____ <b>Pumpco MPF</b> Type <b>PVC</b> Dia. <b>6</b> Slot/gauze <b>1020</b> Length <b>20</b> Set between <b>100</b> ft. and <b>120</b> ft. _____ ft. and _____ ft. Gravel pack? <input checked="" type="checkbox"/> Size range of material <b>10/20-4/60</b>		
				11. Static water level: _____ mo./day/yr. <b>60</b> ft. below land surface Date <b>12-6-78</b>		
				12. Pumping level below land surfaces: _____ ft. after _____ hrs. pumping _____ g.p.m. _____ ft. after _____ hrs. pumping _____ g.p.m. Estimated maximum yield <b>100</b> g.p.m.		
				13. Water sample submitted: _____ mo./day/yr. Yes <input checked="" type="checkbox"/> No <input type="checkbox"/> Date _____		
				14. Well head completion: <b>CAP</b> _____ Pitless adapter <b>24</b> Inches above grade		
				15. Well grouted? <input checked="" type="checkbox"/> With: <input checked="" type="checkbox"/> Neat cement <input type="checkbox"/> Bentonite <input type="checkbox"/> Concrete Depth: From <b>5</b> ft. to <b>15</b> ft.		
				16. Nearest source of possible contamination: ft. <b>300</b> Direction <b>NE</b> Type <b>SEPTIC</b> Well disinfected upon completion? <input checked="" type="checkbox"/> Yes <input type="checkbox"/> No		
				17. Pump: <input checked="" type="checkbox"/> Not installed Manufacturer's name _____ Model number _____ HP _____ Volts _____ Length of drop pipe _____ ft. capacity _____ g.p.m. Type: <input type="checkbox"/> Submersible <input type="checkbox"/> Turbine <input type="checkbox"/> Jet <input type="checkbox"/> Reciprocating <input type="checkbox"/> Centrifugal <input type="checkbox"/> Other		
(Use a second sheet if needed)						
18. Elevation:		19. Remarks:		20. Water well contractor's certification:		
Topography: <input checked="" type="checkbox"/> Hill <input type="checkbox"/> Slope <input type="checkbox"/> Upland <input type="checkbox"/> Valley		<b>OWNER TO INSTALL SW6</b>		This well was drilled under my jurisdiction and this report is true to the best of my knowledge and belief. <b>STRADER D&amp;S Co. 182</b> Business name _____ License No. _____ Address <b>Halter, KS</b> Signed <b>Chris Rucker</b> Date <b>12-8-78</b> Authorized representative		