

WATER WELL RECORD Form WWC-5 KSA 82a-1212


1 LOCATION OF WATER WELL: County: <u>POTT</u>	Fraction <u>SW 1/4 SW 1/4 SW 1/4</u>	Section Number <u>7</u>	Township Number <u>T 10 S</u>	Range Number <u>R 9 E/W</u>
--	---	----------------------------	----------------------------------	--------------------------------

Distance and direction from nearest town or city street address of well if located within city? From St George Go 2 miles west on Military Trail Rd or Old Hwy 24

2 WATER WELL OWNER: Dennis Hilgert
 RR#, St. Address, Box #: 10995 East Highway 24
 City, State, ZIP Code: St. George, Kansas 66535

Board of Agriculture, Division of Water Resources
Application Number:

3 LOCATE WELL'S LOCATION WITH AN "X" IN SECTION BOX:

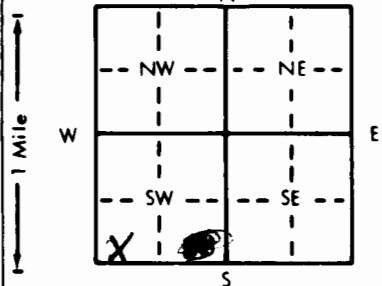

4 DEPTH OF COMPLETED WELL: 38 ft. ELEVATION: _____ ft.

Depth(s) Groundwater Encountered 1.17 ft. 2. _____ ft. 3. _____ ft.

WELL'S STATIC WATER LEVEL 15 ft. below land surface measured on mo/day/yr

Pump test data: Well water was _____ ft. after _____ hours pumping _____ gpm
 Est. Yield 11 gpm Well water was _____ ft. after _____ hours pumping _____ gpm

Bore Hole Diameter 10 in. to _____ ft., and _____ in. to _____ ft.

WELL WATER TO BE USED AS:
 Domestic 3 Feedlot 6 Oil field water supply 9 Dewatering 12 Other (Specify below)
 2 Irrigation 4 Industrial 7 Lawn and garden only 10 Monitoring well

Was a chemical/bacteriological sample submitted to Department? Yes _____ No _____ If yes, mo/day/yr sample was submitted _____
 Water Well Disinfected Yes No

5 TYPE OF CASING USED:

1 Steel	3 RMP (SR)	5 Wrought iron	8 Concrete tile	CASING JOINTS: <input checked="" type="checkbox"/> Glued <input type="checkbox"/> Clamped
<input checked="" type="checkbox"/> 2 PVC	4 ABS	6 Asbestos-Cement	9 Other (specify below)	<input type="checkbox"/> Welded
		7 Fiberglass		<input type="checkbox"/> Threaded

Blank casing diameter _____ in. to 20 ft. Dia _____ in. to _____ ft. Dia _____ in. to _____ ft.

Casing height above land surface 3 in. weight 5.76 lbs./ft. Wall thickness or gauge No. _____

TYPE OF SCREEN OR PERFORATION MATERIAL:

1 Steel	3 Stainless steel	5 Fiberglass	<input checked="" type="checkbox"/> 7 PVC	10 Asbestos-cement
2 Brass	4 Galvanized steel	6 Concrete tile	8 RMP (SR)	11 Other (specify) _____
			9 ABS	12 None used (open hole)

SCREEN OR PERFORATION OPENINGS ARE:

1 Continuous slot	<input checked="" type="checkbox"/> 3 Mill slot	5 Gauzed wrapped	8 Saw cut	11 None (open hole)
2 Louvered shutter	4 Key punched	6 Wire wrapped	9 Drilled holes	
		7 Torch cut	10 Other (specify) _____	

SCREEN-PERFORATED INTERVALS: From _____ ft. to 38 ft., From _____ ft. to _____ ft.

GRAVEL PACK INTERVALS: From _____ ft. to 38 ft., From _____ ft. to _____ ft.

6 GROUT MATERIAL: 1 Neat cement 2 Cement grout 3 Bentonite 4 Other _____

Grout Intervals: From _____ ft. to 20 ft., From _____ ft. to _____ ft., From _____ ft. to _____ ft.

What is the nearest source of possible contamination: None Close

1 Septic tank	4 Lateral lines	7 Pit privy	10 Livestock pens	14 Abandoned water well
2 Sewer lines	5 Cess pool	8 Sewage lagoon	11 Fuel storage	15 Oil well/Gas well
3 Watertight sewer lines	6 Seepage pit	9 Feedyard	12 Fertilizer storage	16 Other (specify below)
			13 Insecticide storage	

Direction from well? _____ How many feet? _____

FROM	TO	LITHOLOGIC LOG	FROM	TO	PLUGGING INTERVALS
0	1	Top Soil			
1	17	Sandy Clay			
17	36	Medium Sand (W/TC)			
36	38	Clay Shale			

7 CONTRACTOR'S OR LANDOWNER'S CERTIFICATION: This water well was (1) constructed, (2) reconstructed, or (3) plugged under my jurisdiction and was completed on (mo/day/year) 1/5/94 and this record is true to the best of my knowledge and belief. Kansas Water Well Contractor's License No. 451 This Water Well Record was completed on (mo/day/yr) 1/29/94 under the business name of Haldeman Well Drilling by (signature) Wayne Cuppe

INSTRUCTIONS: Use typewriter or ball point pen. PLEASE PRESS FIRMLY and PRINT clearly. Please fill in blanks, underline or circle the correct answers. Send top three copies to Kansas Department of Health and Environment, Bureau of Water, Topeka, Kansas 66620-0001. Telephone: 913-296-5545. Send one to WATER WELL OWNER and retain one for your records.