


LOCATION OF WATER WELL: County: Pottawatomie Fraction: NW 1/4 SE 1/4 NW 1/4 Section Number: 7 Township Number: T 10 S Range Number: R 9 E/W

Distance and direction from nearest town or city street address of well if located within city?

4 1/2 mi. east of Manhattan

WATER WELL OWNER: State of Kansas
 RR#, St. Address, Box #: c/o Kan. Dept. of Transportation
 City, State, ZIP Code: Docking State Office Bldg., Topeka, Ks.
 Board of Agriculture, Division of Water Resources
 Application Number: NA

LOCATE WELL'S LOCATION WITH AN "X" IN SECTION BOX: DEPTH OF COMPLETED WELL: approx. 75 ft. ELEVATION: unk.

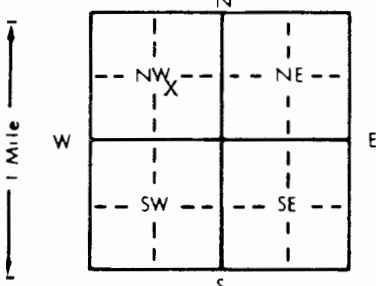

Depth(s) Groundwater Encountered 1. 30' ft. 2. _____ ft. 3. _____ ft.
 WELL'S STATIC WATER LEVEL 30' ft. below land surface measured on mo/day/yr 1/12/94
 Pump test data: Well water was N/A ft. after _____ hours pumping _____ gpm
 Est. Yield _____ gpm: Well water was _____ ft. after _____ hours pumping _____ gpm
 Bore Hole Diameter _____ in. to _____ ft., and _____ in. to _____ ft.
 WELL WATER TO BE USED AS:
 1 Domestic 2 Irrigation 3 Feedlot 4 Industrial
 5 Public water supply 6 Oil field water supply 7 Lawn and garden only
 8 Air conditioning 9 Dewatering 10 Monitoring well
 11 Injection well 12 Other (Specify below) _____
 Was a chemical/bacteriological sample submitted to Department? Yes _____ No _____; If yes, mo/day/yr sample was submitted _____
 Water Well Disinfected? Yes _____ No _____

TYPE OF BLANK CASING USED: 2
 1 Steel 3 RMP (SR) 5 Wrought iron 8 Concrete tile CASING JOINTS: Glued _____ Clamped _____
 2 PVC 4 ABS 6 Asbestos-Cement 9 Other (specify below) _____ Welded UNK.
 7 Fiberglass Threaded _____

Blank casing diameter 6 in. to at surf. ft., Dia _____ in. to _____ ft., Dia _____ in. to _____ ft.
 Casing height above land surface 24 in., weight unk. lbs./ft. Wall thickness or gauge No. 1/4 in.

TYPE OF SCREEN OR PERFORATION MATERIAL:
 1 Steel 3 Stainless steel 5 Fiberglass 8 RMP (SR) 10 Asbestos-cement
 2 Brass 4 Galvanized steel 6 Concrete tile 9 ABS 11 Other (specify) unknown
 12 None used (open hole)

SCREEN OR PERFORATION OPENINGS ARE:
 1 Continuous slot 3 Mill slot 5 Gauzed wrapped 8 Saw cut 11 None (open hole)
 2 Louvered shutter 4 Key punched 6 Wire wrapped 9 Drilled holes
 7 Torch cut 10 Other (specify) unk.

SCREEN-PERFORATED INTERVALS: From unknown ft. to _____ ft., From _____ ft. to _____ ft.
 From _____ ft. to _____ ft., From _____ ft. to _____ ft.

GRAVEL PACK INTERVALS: From unk. ft. to _____ ft., From _____ ft. to _____ ft.
 From _____ ft. to _____ ft., From _____ ft. to _____ ft.

GROUT MATERIAL: 1 Neat cement 2 Cement grout 3 Bentonite 4 Other unk.
 Grout Intervals: From 28 ft. to 18 ft., From 10 ft. to 5 ft., From _____ ft. to _____ ft.

What is the nearest source of possible contamination: 3
 1 Septic tank 4 Lateral lines 7 Pit privy 10 Livestock pens 14 Abandoned water well
 2 Sewer lines 5 Cess pool 8 Sewage lagoon 11 Fuel storage 15 Oil well/Gas well
 3 Watertight sewer lines 6 Seepage pit 9 Feedyard 12 Fertilizer storage 16 Other (specify below) _____
 13 Insecticide storage

Direction from well? south How many feet? 100 approx.

FROM	TO	LITHOLOGIC LOG	FROM	TO	PLUGGING INTERVALS
			0	5	Chlorinated sand
			5	10	Bentonite
			10	18	Chl. Sand
			18	28	Bent.
			28	75	Chl. Sand (TD)

CONTRACTOR'S OR LANDOWNER'S CERTIFICATION: This water well was (1) constructed, (2) reconstructed, or (3) plugged under my jurisdiction and was completed on (mo/day/year) 1/12/94 and this record is true to the best of my knowledge and belief. Kansas Water Well Contractor's License No. _____ This Water Well Record was completed on (mo/day/yr) 1/13/94 under the business name of Kansas Dept. of Transportation by (signature) D.C.