


LOCATION OF WATER WELL: Pottawatomie
 County: Pottawatomie Fraction NW 1/4 SE 1/4 NW 1/4 Section Number 7 Township Number T 10 S Range Number R 9 E

Distance and direction from nearest town or city street address of well if located within city?

4 1/2 mi. East of Manhattan, Ks.

WATER WELL OWNER: State of Kansas, c/o Kansas Dept. of Transportation
 RR#, St. Address, Box #: Docking State Office Bldg. Board of Agriculture, Division of Water Resources
 City, State, ZIP Code: Topeka, Kansas 66612 Application Number: NA

LOCATE WELL'S LOCATION WITH AN "X" IN SECTION BOX: DEPTH OF COMPLETED WELL apprx. 83 ft. ELEVATION: unk.

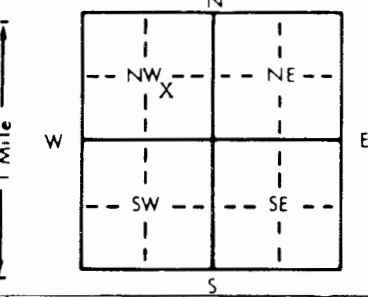

Depth(s) Groundwater Encountered 1. 39 ft. 2. 39 ft. 3. unk. ft.
 WELL'S STATIC WATER LEVEL 39 ft. below land surface measured on mo/day/yr 1/12/94
 Pump test data: Well water was n/a ft. after unk. hours pumping unk. gpr
 Est. Yield unk. gpm: Well water was unk. ft. after unk. hours pumping unk. gpr
 Bore Hole Diameter unk. in. to unk. ft., and unk. in. to unk. ft.
 WELL WATER TO BE USED AS: 1 5 Public water supply 8 Air conditioning 11 Injection well
1 Domestic 3 Feedlot 6 Oil field water supply 9 Dewatering 12 Other (Specify below)
2 Irrigation 4 Industrial 7 Lawn and garden only 10 Monitoring well
 Was a chemical/bacteriological sample submitted to Department? Yes unk. No unk.; If yes, mo/day/yr sample was submitted unk.
 Water Well Disinfected? Yes unk. No unk.

TYPE OF BLANK CASING USED: 5 5 Wrought iron 8 Concrete tile CASING JOINTS: unk. Glued unk. Clamped unk.
1 Steel 3 RMP (SR) 6 Asbestos-Cement 9 Other (specify below) Welded unk.
2 PVC 4 ABS 7 Fiberglass Threaded unk.

Blank casing diameter 6 in. to unk. ft., Dia unk. in. to unk. ft., Dia unk. in. to unk. ft.
 Casing height above land surface 24 in., weight unk. lbs./ft. Wall thickness or gauge No. apprx. 1/4 in.

TYPE OF SCREEN OR PERFORATION MATERIAL: 7 PVC 10 Asbestos-cement
1 Steel 3 Stainless steel 5 Fiberglass 8 RMP (SR) 11 Other (specify) unknown
2 Brass 4 Galvanized steel 6 Concrete tile 9 ABS 12 None used (open hole)

SCREEN OR PERFORATION OPENINGS ARE: 5 Gauzed wrapped 8 Saw cut 11 None (open hole)
1 Continuous slot 3 Mill slot 6 Wire wrapped 9 Drilled holes
2 Louvered shutter 4 Key punched 7 Torch cut 10 Other (specify) unknown

SCREEN-PERFORATED INTERVALS: From unk. ft. to unk. ft., From unk. ft. to unk. ft., From unk. ft. to unk. ft.
 GRAVEL PACK INTERVALS: From unk. ft. to unk. ft., From unk. ft. to unk. ft., From unk. ft. to unk. ft.

GROUT MATERIAL: 1 Neat cement 2 Cement grout 18 3 Bentonite 8 4 Other unknown
 Grout Intervals: From 38 ft. to 28 ft., From 18 ft. to 8 ft., From unk. ft. to unk. ft.

What is the nearest source of possible contamination: 2 10 Livestock pens 14 Abandoned water well
1 Septic tank 4 Lateral lines 7 Pit privy 11 Fuel storage 15 Oil well/Gas well
2 Sewer lines 5 Cess pool 8 Sewage lagoon 12 Fertilizer storage 16 Other (specify below)
3 Watertight sewer lines 6 Seepage pit 9 Feedyard 13 Insecticide storage

Direction from well? How many feet? unk.

FROM	TO	LITHOLOGIC LOG	FROM	TO	PLUGGING INTERVALS
			0	8	Chlorinated sand
			8	18	Bentonite
			18	28	Chl. sand
			28	38	Bentonite
			38	83	Chl. sand (TD)

CONTRACTOR'S OR LANDOWNER'S CERTIFICATION: This water well was (1) constructed, (2) reconstructed, or (3) plugged under my jurisdiction and was completed on (mo/day/year) 1/12/94 and this record is true to the best of my knowledge and belief. Kansas Water Well Contractor's License No. na This Water Well Record was completed on (mo/day/yr) 1/13/94 under the business name of Kansas Dept. of Transportation by (signature) Del