

6k

USE TYPEWRITER OR BALL POINT PEN-PRESS FIRMLY, PRINT CLEARLY.

T R EW sec 1/4 1/4 1/4 No.

WATER WELL RECORD KSA 82a-1201-1215


Kansas State Dept. Of Health (Water Well Contractors) Forbes-Bldg. 740 Topeka, Kansas 66620

Well # 6

NE SW NW

1 Location of well:	County <b>Pottawatomie</b>	Township name <b>10</b>	Fraction <b>SW 1/4 of NE 1/4</b>	Section number <b>8</b>	Town number <b>10</b>	Range number <b>9 E</b>
---------------------	-------------------------------	----------------------------	-------------------------------------	----------------------------	--------------------------	----------------------------

Distance and direction from nearest town or city: \_\_\_\_\_  
 Street address of well location if in city: \_\_\_\_\_  
 3 Owner of well: **Milton Anderson**  
 Address: **Anderson Realty**  
**103 S. 4th, Manhattan, Kans.**

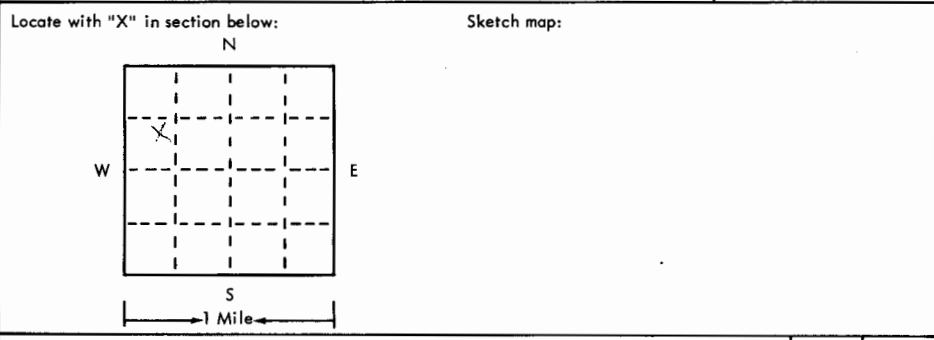

4 Well depth: **86** ft. Date of completion **7/7/75**  
 Well diameter **8** in.

5  Cable tool  Rotary  Driven  Dug  
 Hollow rod  Jetted  Bored  Reverse rotary

6 Use:  Domestic  Public supply  Industry  
 Irrigation  Air conditioning  Commercial  
 Test well  \_\_\_\_\_

7 Casing: Material **RMP** Height: above/below  
 Threading:  Threaded  Welded  Surface **18** in.  
 Diam. **5** in. to **86** ft. depth: Drive shoe?  Yes  No  
 Weight **200** lbs./ft.  
 \_\_\_ in. to \_\_\_ ft. depth: \_\_\_

2 Type and color of material	From	To
Sand	0	56
Coarse sand and clay	56	59
Clay and rock	59	64
Blue	64	73
Rock and flint (very hard)		
Blue	76	83
Blue and limestone	83	86

(use a second sheet if needed)

8 Screen: Manufacturer **Western Plastics**  
 Type **RMP** Dia. **5"**  
 Slot/gauze **3/32"** Length **2 1/2"**  
 Set between **56** ft. and **86** ft.  
 Fittings: **1/16 to 3/8**  
 Gravel pack  Yes  No Size range of material \_\_\_

9 Static water level: **51** ft. below land surface Date **7/7/75**

10 Pumping level below land surfaces:  
 \_\_\_ ft. after \_\_\_ hrs. pumping \_\_\_ g.p.m.  
 \_\_\_ ft. after \_\_\_ hrs. pumping \_\_\_ g.p.m.  
 Estimated maximum yield **16** g.p.m.

11 Water sample submitted:  
 Yes  No Date \_\_\_

12 Well head completion: **capped**  
 Pitless adapter **18** Inches above grade

13 Well grouted?  Yes  No  
 Neat cement  Bentonite  \_\_\_\_\_  
 Depth: From **0** ft. to **10** ft.

14 Nearest source of possible contamination: **none**  
 ft. \_\_\_ Direction \_\_\_ Type \_\_\_  
 Well disinfected upon completion?  Yes  No

15 Pump:  Not installed  
 Manufacturer's name \_\_\_\_\_  
 Model number \_\_\_\_\_ HP \_\_\_\_\_ Volts \_\_\_\_\_  
 Length of drop pipe \_\_\_\_\_ ft. capacity \_\_\_\_\_ g.p.m.  
 Type:  
 Submersible  Turbine  
 Jet  Reciprocating  
 Centrifugal  Other

16 Remarks: elevation **1075'**

Topography:  
 Hill  
 Slope  
 Upland  
 Valley

17 Water well contractor's certification:  
 This well was drilled under my jurisdiction and this report is true to the best of my knowledge and belief.  
**Rader Drilling Co. 194**  
 Business name \_\_\_\_\_ License No. \_\_\_\_\_  
 Address **Carlton, Kansas**  
 Signed **Ben E Rader** Date **7-24-75**  
 Authorized representative