


1 LOCATION OF WATER WELL: Fraction SW 1/4 NW 1/4 SE 1/4 Section Number 8 Township Number T 10 S Range Number R 9 E  
 County: Pottawatomie

Distance and direction from nearest town or city street address of well if located within city?  
1 W of St George

2 WATER WELL OWNER: Kirby Hawkins RAY'S JOB  
 RR#, St. Address, Box # : St. George, KS 66535 Board of Agriculture, Division of Water Resources  
 City, State, ZIP Code : Application Number:

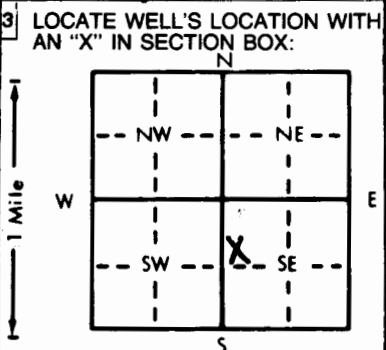

4 DEPTH OF COMPLETED WELL... 80 ft. ELEVATION: .....  
 Depth(s) Groundwater Encountered 1. .... 30 ft. 2. .... ft. 3. .... ft.  
 WELL'S STATIC WATER LEVEL ... 19' ft. below land surface measured on mo/day/yr ... 6-27-88  
 Pump test data: Well water was ..... ft. after ..... hours pumping ..... gpm  
 Est. Yield .10 gpm: Well water was ..... ft. after ..... hours pumping ..... gpm  
 Bore Hole Diameter ... 12" in. to ..... ft., and ..... in. to ..... ft.  
 WELL WATER TO BE USED AS: 5 Public water supply 8 Air conditioning 11 Injection well  
 1 Domestic 3 Feedlot 6 Oil field water supply 9 Dewatering 12 Other (Specify below)  
 2 Irrigation 4 Industrial 7 Lawn and garden only 10 Monitoring well .....  
 Was a chemical/bacteriological sample submitted to Department? Yes.....No... X.....; If yes, mo/day/yr sample was submitted  
 Water Well Disinfected? Yes X No

5 TYPE OF BLANK CASING USED: 5 Wrought iron 8 Concrete tile CASING JOINTS: Glued X Clamped .....  
 1 Steel 3 RMP (SR) 6 Asbestos-Cement 9 Other (specify below) Welded .....  
 2 PVC 4 ABS 7 Fiberglass Threaded.....

Blank casing diameter ..... 5" in. to .. 0-23 ft., Dia ... 5" in. to .. 31-79 ft., Dia ..... in. to ..... ft.  
 Casing height above land surface ..... 24" in., weight ... 2.82 lbs./ft. Wall thickness or gauge No. ... 258

TYPE OF SCREEN OR PERFORATION MATERIAL: 7 PVC 10 Asbestos-cement  
 1 Steel 3 Stainless steel 5 Fiberglass 8 RMP (SR) 11 Other (specify) .....  
 2 Brass 4 Galvanized steel 6 Concrete tile 9 ABS 12 None used (open hole)

SCREEN OR PERFORATION OPENINGS ARE: 5 Gauzed wrapped 8 Saw cut 11 None (open hole)  
 1 Continuous slot 3 Mill slot 6 Wire wrapped 9 Drilled holes  
 2 Louvered shutter 4 Key punched 7 Torch cut 10 Other (specify) .....

SCREEN-PERFORATED INTERVALS: From ... 23 ft. to ... 31 ft., From ..... ft. to ..... ft.  
 From ... 79 ft. to ... 80 ft., From ..... ft. to ..... ft.  
 GRAVEL PACK INTERVALS: From ... 20 ft. to ... 80 ft., From ..... ft. to ..... ft.  
 From ..... ft. to ..... ft., From ..... ft. to ..... ft.

6 GROUT MATERIAL: 1 Neat cement 2 Cement grout 3 Bentonite 4 Other .....  
 Grout intervals: From ..... 0 ft. to ... 20 ft., From ..... ft. to ..... ft., From ..... ft. to ..... ft.

What is the nearest source of possible contamination:  
 1 Septic tank 4 Lateral lines 7 Pit privy 10 Livestock pens 14 Abandoned water well  
 2 Sewer lines 5 Cess pool 8 Sewage lagoon 11 Fuel storage 15 Oil well/Gas well  
 3 Watertight sewer lines 6 Seepage pit 9 Feedyard 12 Fertilizer storage 16 Other (specify below)  
 13 Insecticide storage .....

Direction from well? N How many feet? 175

FROM	TO	LITHOLOGIC LOG	FROM	TO	PLUGGING INTERVALS
0	3	Top Soil			
3	18	Clay-Brown			
18	30	Fine Sand-Brown			
30	31	Boulders			
31	39	Shale-Yellow			
39	44	Limestone-Grey			
44	48	Shale-Grey			
48	49	Limestone-Grey			
49	61	Shale-Grey			
61	63	Limestone-Grey			
63	80	Shale-Grey			

7 CONTRACTOR'S OR LANDOWNER'S CERTIFICATION: This water well was (1) constructed, (2) reconstructed, or (3) plugged under my jurisdiction and was completed on (mo/day/year) ..... 6-27-88 ..... and this record is true to the best of my knowledge and belief. Kansas Water Well Contractor's License No. .... 182 ..... This Water Well Record was completed on (mo/day/yr) ... 7-27-88 ..... under the business name of Strader Drilling Co., Inc. by (signature) Dale Strader