


1 LOCATION OF WATER WELL: Fraction SE 1/4 SE 1/4 SW 1/4 Section Number 8 Township Number T 10 S Range Number R 9 **(EW)**  
 County: **POTTAWATOMIE**

Distance and direction from nearest town or city street address of well if located within city?  
**1 mile west of St. George**

2 WATER WELL OWNER: **Carl Meyer**  
 RR#, St. Address, Box # : **St. George, KS 66535** Board of Agriculture, Division of Water Resources  
 City, State, ZIP Code : Application Number:

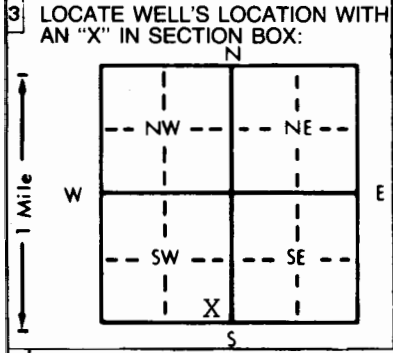

4 DEPTH OF COMPLETED WELL... **37** ft. ELEVATION: .....  
 Depth(s) Groundwater Encountered 1. **16** ft. 2. .... ft. 3. .... ft.  
 WELL'S STATIC WATER LEVEL... **13'** ft. below land surface measured on mo/day/yr **9-13-88**  
 Pump test data: Well water was ..... ft. after ..... hours pumping ..... gpm  
 Est. Yield... **.75** gpm: Well water was ..... ft. after ..... hours pumping ..... gpm  
 Bore Hole Diameter... **12** in. to ..... ft. and ..... in. to ..... ft.  
 WELL WATER TO BE USED AS: 5 Public water supply 8 Air conditioning 11 Injection well  
 1 Domestic 3 Feedlot 6 Oil field water supply 9 Dewatering 12 Other (Specify below)  
2 Irrigation 4 Industrial 7 Lawn and garden only 10 Monitoring well .....  
 Was a chemical/bacteriological sample submitted to Department? Yes.....No.....; If yes, mo/day/yr sample was submitted  
 Water Well Disinfected? Yes No

5 TYPE OF BLANK CASING USED: 5 Wrought iron 8 Concrete tile CASING JOINTS: Glued ..... Clamped .....  
 1 Steel 3 RMP (SR) 6 Asbestos-Cement 9 Other (specify below) Welded .....  
 2 PVC 4 ABS 7 Fiberglass ..... Threaded .....  
 Blank casing diameter... **.6"** in. to... **0-18** ft., Dia... **6"** in. to... **23-37** ft., Dia... in. to... ft.  
 Casing height above land surface... **24"** in., weight... **3.67** lbs./ft. Wall thickness or gauge No. **.280**  
 TYPE OF SCREEN OR PERFORATION MATERIAL: 7 PVC JOHNSON 10 Asbestos-cement  
 1 Steel 3 Stainless steel 5 Fiberglass 8 RMP (SR) 11 Other (specify) .....  
 2 Brass 4 Galvanized steel 6 Concrete tile 9 ABS 12 None used (open hole)  
 SCREEN OR PERFORATION OPENINGS ARE: 5 Gauzed wrapped 8 Saw cut 11 None (open hole)  
 1 Continuous slot **.030** 3 Mill slot 6 Wire wrapped 9 Drilled holes  
 2 Louvered shutter 4 Key punched 7 Torch cut 10 Other (specify) .....  
 SCREEN-PERFORATED INTERVALS: From... **18** ft. to... **23** ft., From ..... ft. to ..... ft.  
 From ..... ft. to ..... ft., From ..... ft. to ..... ft.  
 GRAVEL PACK INTERVALS: From... **15** ft. to... **37** ft., From ..... ft. to ..... ft.  
 From ..... ft. to ..... ft., From ..... ft. to ..... ft.

6 GROUT MATERIAL: 1 Neat cement 2 Cement grout 3 Bentonite 4 Other .....  
 Grout Intervals: From... **0** ft. to... **15** ft., From ..... ft. to ..... ft., From ..... ft. to ..... ft.  
 What is the nearest source of possible contamination:  
 1 Septic tank 4 Lateral lines 7 Pit privy 10 Livestock pens 14 Abandoned water well  
 2 Sewer lines 5 Cess pool 8 Sewage lagoon 11 Fuel storage 15 Oil well/Gas well  
 3 Watertight sewer lines 6 Seepage pit 9 Feedyard 12 Fertilizer storage 16 Other (specify below)  
 13 Insecticide storage .....  
 Direction from well? **N** How many feet? **820**

FROM	TO	LITHOLOGIC LOG	FROM	TO	PLUGGING INTERVALS
0	9	Silty Brown Clay			
9	16	Fine Sand-Brown			
16	23	Fine Sand-Coarse Sand-Med Pea Gravel, Brown			
23	24	Shale-Grey			NOTE: 9-15-88 Darrell Plummer gave approval for grouting 0-15'
24	26	Limestone-grey			
26	37	Shale-Grey			

7 CONTRACTOR'S OR LANDOWNER'S CERTIFICATION: This water well was (1) constructed, (2) reconstructed, or (3) plugged under my jurisdiction and was completed on (mo/day/year) **9-13-88** and this record is true to the best of my knowledge and belief. Kansas Water Well Contractor's License No. **182** This Water Well Record was completed on (mo/day/yr) **10-18-88** under the business name of **Strader Drilling Co., Inc.** by (signature) *Dale Strader*