


1 LOCATION OF WATER WELL: Fraction SW 1/4 SW 1/4 SW 1/4 Section Number 8 Township Number T 10 S Range Number R 9 EAW
 County: POTTAWATOMIE

Distance and direction from nearest town or city street address of well if located within city?
SOUTH OF OLD HIWY. 24 AND FLUSH RD. - ST. GEORGE KS.

2 WATER WELL OWNER: A. C. CHANDLER Board of Agriculture, Division of Water Resources
 RR#, St. Address, Box # : 920 LARAMIE MANHATTAN KS. 66502 Application Number:
 City, State, ZIP Code :

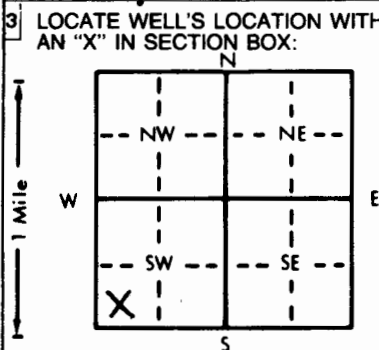

4 DEPTH OF COMPLETED WELL 36 ft. ELEVATION: -
 Depth(s) Groundwater Encountered 1. 22 ft. 2. - ft. 3. - ft.
 WELL'S STATIC WATER LEVEL 18 ft. below land surface measured on mo/day/yr 06-12-93
 Pump test data: Well water was - ft. after - hours pumping - gpm
 Est. Yield 3 gpm: Well water was - ft. after - hours pumping - gpm
 Bore Hole Diameter 11.75 in. to 42 ft., and - in. to - ft.
 WELL WATER TO BE USED AS:
 1 Domestic 3 Feedlot 6 Oil field water supply 9 Dewatering 12 Other (Specify below)
 2 Irrigation 4 Industrial 7 Lawn and garden only 10 Monitoring well
 Was a chemical/bacteriological sample submitted to Department? Yes - No X; If yes, mo/day/yr sample was submitted -
 Water Well Disinfected? Yes X No -

5 TYPE OF BLANK CASING USED:
 1 Steel 3 RMP (SR) 5 Wrought iron 8 Concrete tile CASING JOINTS: Glued X Clamped -
 2 PVC 4 ABS 6 Asbestos-Cement 9 Other (specify below) Welded -
 7 Fiberglass Threaded -
 Blank casing diameter 5 in. to 11 ft., Dia - in. to - ft., Dia - in. to - ft.
 Casing height above land surface 28 in., weight 344.41 lbs./ft. Wall thickness or gauge No. -
 TYPE OF SCREEN OR PERFORATION MATERIAL:
 1 Steel 3 Stainless steel 5 Fiberglass 7 PVC 10 Asbestos-cement
 2 Brass 4 Galvanized steel 6 Concrete tile 8 RMP (SR) 11 Other (specify) -
 9 ABS 12 None used (open hole)
 SCREEN OR PERFORATION OPENINGS ARE:
 1 Continuous slot 3 Mill slot 5 Gauzed wrapped 8 Saw cut 11 None (open hole)
 2 Louvered shutter 4 Key punched 6 Wire wrapped 9 Drilled holes
 7 Torch cut 10 Other (specify) -
 SCREEN-PERFORATED INTERVALS: From 11 ft. to 36 ft., From - ft. to - ft.
 From - ft. to - ft., From - ft. to - ft.
 SAND GRAVEL PACK INTERVALS: From 10 ft. to 42 ft., From - ft. to - ft.
 From - ft. to - ft., From - ft. to - ft.

6 GROUT MATERIAL: 1 Neat cement 2 Cement grout 3 Bentonite 4 Other BENTONITE GROUT
 Grout Intervals: 7 From 3 ft. to 9 ft., From 9 ft. to 10 ft., From - ft. to - ft.
 What is the nearest source of possible contamination:
 1 Septic tank 4 Lateral lines 7 Pit privy 10 Livestock pens 14 Abandoned water well
 2 Sewer lines 5 Cess pool 8 Sewage lagoon 11 Fuel storage 15 Oil well/Gas well
 3 Watertight sewer lines 6 Seepage pit 9 Feedyard 12 Fertilizer storage 16 Other (specify below)
 13 Insecticide storage
 Direction from well? NW How many feet? 300 +

FROM	TO	LITHOLOGIC LOG	FROM	TO	PLUGGING INTERVALS
<u>6L</u>	<u>5</u>	<u>SOIL- SILTY SAND</u>			
<u>5</u>	<u>12</u>	<u>CLAY</u>			
<u>12</u>	<u>17</u>	<u>FINE SAND</u>			
<u>17</u>	<u>25</u>	<u>SAND - MED TO COARSE</u>			
<u>25</u>	<u>30</u>	<u>SAND COARSE</u>			
<u>30</u>	<u>35</u>	<u>CLAYEY SAND</u>			
<u>35</u>	<u>42</u>	<u>SHALE</u>			

7 CONTRACTOR'S OR LANDOWNER'S CERTIFICATION: This water well was (1) constructed, (2) reconstructed, or (3) plugged under my jurisdiction and was completed on (mo/day/year) 06-12-93 and this record is true to the best of my knowledge and belief. Kansas Water Well Contractor's License No. 479 This Water Well Record was completed on (mo/day/yr) 07-02-93 under the business name of EBBERTS DRILLING by (signature) Gregory Ebberts