


1 LOCATION OF WATER WELL: County: Pott Fraction: SW 1/4 NW 1/4 SE 1/4 Section Number: 8 Township Number: T 10 S Range Number: R 9 E/W
 Distance and direction from nearest town or city street address of well if located within city? 60 1/2 mile west of St George, KS on Highway 24 + 60 South 11th

2 WATER WELL OWNER: MURPHY THOMPSON
 RR#, St. Address, Box #: 12250 MILITARY TRAIL RD. Board of Agriculture, Division of Water Resources
 City, State, ZIP Code: ST. GEORGE, KANSAS 66535 Application Number:

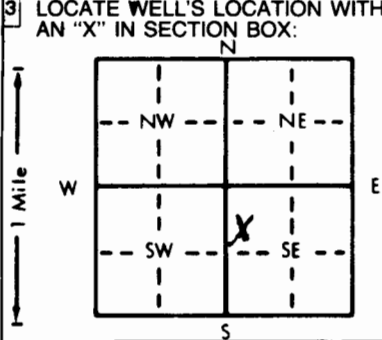

4 DEPTH OF COMPLETED WELL: 40 ft. ELEVATION:
 Depth(s) Groundwater Encountered 1. 20 ft. 2. ft. 3. ft.
 WELL'S STATIC WATER LEVEL: 20 ft. below land surface measured on mo/day/yr
 Pump test data: Well water was ft. after hours pumping gpm
 Est. Yield: 8 gpm: Well water was ft. after hours pumping gpm
 Bore Hole Diameter: 10 in. to 40 ft. and in. to ft.
 WELL WATER TO BE USED AS:
 1 Domestic 3 Feedlot 6 Oil field water supply 8 Air conditioning 11 Injection well
 2 Irrigation 4 Industrial 7 Lawn and garden only 10 Monitoring well 12 Other (Specify below)
 Was a chemical/bacteriological sample submitted to Department? Yes.....No.....; If yes, mo/day/yr sample was submitted Water Well Disinfected? Yes No

5 TYPE OF BLANK CASING USED:
 1 Steel 3 RMP (SR) 5 Wrought iron 8 Concrete tile CASING JOINTS: Glued Clamped
 2 PVC 4 ABS 6 Asbestos-Cement 9 Other (specify below) Welded
 Blank casing diameter: 5 in. to 20 ft., Dia. in. to ft., Dia. in. to ft.
 Casing height above land surface: 2 in., weight Sch. 40 lbs./ft. Wall thickness or gauge No.
 TYPE OF SCREEN OR PERFORATION MATERIAL:
 1 Steel 3 Stainless steel 5 Fiberglass 7 PVC 10 Asbestos-cement
 2 Brass 4 Galvanized steel 6 Concrete tile 8 RMP (SR) 11 Other (specify)
 3 Mill slot 13 1/4000's 5 Gauzed wrapped 8 Saw cut 11 None (open hole)
 1 Continuous slot 4 Key punched 6 Wire wrapped 9 Drilled holes
 2 Louvered shutter 7 Torch cut 10 Other (specify)
 SCREEN-PERFORATED INTERVALS: From 20 ft. to 40 ft., From ft. to ft.
 GRAVEL PACK INTERVALS: From 20 ft. to 40 ft., From ft. to ft.

6 GROUT MATERIAL: 1 Neat cement 2 Cement grout 3 Bentonite 4 Other
 Grout Intervals: From 0 ft. to 20 ft., From ft. to ft., From ft. to ft.
 What is the nearest source of possible contamination:
 1 Septic tank 4 Lateral lines 7 Pit privy 10 Livestock pens 14 Abandoned water well
 2 Sewer lines 5 Cess pool 8 Sewage lagoon 11 Fuel storage 15 Oil well/Gas well
 3 Watertight sewer lines 6 Seepage pit 9 Feedyard 12 Fertilizer storage 16 Other (specify below)
 13 Insecticide storage
 Direction from well? South How many feet? 300

FROM	TO	LITHOLOGIC LOG	FROM	TO	PLUGGING INTERVALS
0	2	Top Soil			
2	20	Sandy Clay			
20	26	Fine Sand			
26	31	Coarse Sand (Wafil)			
31	40	Grey Shale			

7 CONTRACTOR'S OR LANDOWNER'S CERTIFICATION: This water well was (1) constructed, (2) reconstructed, or (3) plugged under my jurisdiction and was completed on (mo/day/year) 9/20/93 and this record is true to the best of my knowledge and belief. Kansas Water Well Contractor's License No. 451 This Water Well Record was completed on (mo/day/year) 10/17/93 under the business name of Haldeman Well Drilling by signature Craig Haldeman