


1 LOCATION OF WATER WELL: Fraction NE 1/4 NE 1/4 NW 1/4 Section Number 8 Township Number T 10 S Range Number R 9 EXX
 County: Pottawatomie

Distance and direction from nearest town or city street address of well if located within city?
 5 1/2 mi. east of Manhattan, Ks.

2 WATER WELL OWNER: State of Kansas c/o Kansas Dept. of Transportation
 RR#, St. Address, Box #: Docking State Office Bldg. Board of Agriculture, Division of Water Resources
 City, State, ZIP Code: Topeka, Kansas 66612 Application Number: NA

3 LOCATE WELL'S LOCATION WITH AN "X" IN SECTION BOX:

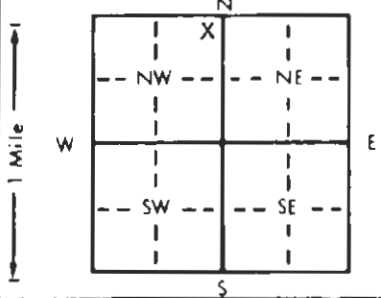

4 DEPTH OF COMPLETED WELL: over 100 ft. ELEVATION: unk.

Depth(s) Groundwater Encountered 1. 50 ft. 2. ft. 3. ft.
 WELL'S STATIC WATER LEVEL 50 ft. below land surface measured on mo/day/yr
 Pump test data: Well water was NA ft. after hours pumping gpm
 Est. Yield gpm: Well water was ft. after hours pumping gpm
 Bore Hole Diameter in. to ft. and in. to ft.
 WELL WATER TO BE USED AS: 1 Domestic 3 Feedlot 6 Oil field water supply 9 Dewatering 12 Other (Specify below)
 2 Irrigation 4 Industrial 7 Lawn and garden only 10 Monitoring well
 Was a chemical/bacteriological sample submitted to Department? Yes No; If yes, mo/day/yr sample was submitted
 Water Well Disinfected? Yes No

5 TYPE OF BLANK CASING USED: 5 Wrought iron 8 Concrete tile CASING JOINTS: Glued Clamped
 1 Steel 3 RMP (SR) 6 Asbestos-Cement 9 Other (specify below) unk. Welded
 2 PVC 4 ABS 7 Fiberglass Threaded

Blank casing diameter 8 in. to at surf. ft. Dia in. to ft. Dia in. to ft.
 Casing height above land surface 30 in. weight lbs./ft. Wall thickness or gauge No. 1/4 inch

TYPE OF SCREEN OR PERFORATION MATERIAL: 7 PVC 10 Asbestos-cement
 1 Steel 3 Stainless steel 5 Fiberglass 8 RMP (SR) 11 Other (specify) unk.
 2 Brass 4 Galvanized steel 6 Concrete tile 9 ABS 12 None used (open hole)

SCREEN OR PERFORATION OPENINGS ARE: 5 Gauzed wrapped 8 Saw cut 11 None (open hole)
 1 Continuous slot 3 Mill slot 6 Wire wrapped 9 Drilled holes
 2 Louvered shutter 4 Key punched 7 Torch cut 10 Other (specify) unk.

SCREEN-PERFORATED INTERVALS: From unk. ft. to ft. From ft. to ft.
 GRAVEL PACK INTERVALS: From unk. ft. to ft. From ft. to ft.

6 GROUT MATERIAL: 1 Neat cement 2 Cement grout 3 Bentonite 4 Other unk.
 Grout Intervals: From 50 ft. to 40 ft. From 20 ft. to 10 ft. From ft. to ft.

What is the nearest source of possible contamination: 1 Septic tank 4 Lateral lines 7 Pit privy 10 Livestock pens 14 Abandoned water well
 2 Sewer lines 5 Cess pool 8 Sewage lagoon 11 Fuel storage 15 Oil well/Gas well
 3 Watertight sewer lines 6 Seepage pit 9 Feedyard 12 Fertilizer storage 16 Other (specify below)
 13 Insecticide storage

Direction from well? North How many feet? 40

FROM	TO	LITHOLOGIC LOG	FROM	TO	PLUGGING INTERVALS
			0	10	Chlorinated sand
			10	20	Bentonite
			20	40	Sand (Chlorinated)
			40	50	Bentonite
			50	TD	Chl. Sand (TD unknown, more than 100 feet)

7 CONTRACTOR'S OR LANDOWNER'S CERTIFICATION: This water well was (1) constructed, (2) reconstructed, or (3) plugged under my jurisdiction and was completed on (mo/day/year) 1/12/94 and this record is true to the best of my knowledge and belief, Kansas Water Well Contractor's License No. NA This Water Well Record was completed on (mo/day/yr) 1/13/94 under the business name of Kansas Dept. of Transportation by (signature) [Signature]