


1] LOCATION OF WATER WELL: Fraction NE 1/4 SE 1/4 SW 1/4 Section Number 9 Township Number T 10 S Range Number R 9E E/W
 County: POTTAWATOMIE
 Distance and direction from nearest town or city street address of well if located within city?

2] WATER WELL OWNER: City of St. George WELL #4 Board of Agriculture, Division of Water Resources
 RR#, St. Address, Box #: City Hall
 City, State, ZIP Code: St. George, KS 66535 Application Number:

3] LOCATE WELL'S LOCATION WITH AN "X" IN SECTION BOX:

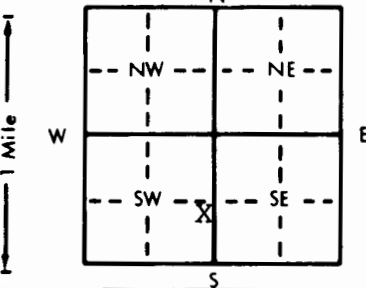

4] DEPTH OF COMPLETED WELL: 77' ft. ELEVATION:
 Depth(s) Groundwater Encountered 1. _____ ft. 2. _____ ft. 3. _____ ft.
 WELL'S STATIC WATER LEVEL: 57' - 7" ft. below land surface measured on 8-04-92
 Pump test data: Well water was 62' - 7 1/2" ft. after 1 hours pumping 35 gpm
 Est. Yield 54.5 gpm Well water was 62' - 7 1/2" ft. after 5 hours pumping 54.5 gpm
 Bore Hole Diameter: 24" in. to _____ ft., and _____ in. to _____ ft.
 WELL WATER TO BE USED AS:
 1 Domestic 2 Irrigation 3 Feedlot 4 Industrial 5 Public water supply 6 Oil field water supply 7 Lawn and garden only 8 Air conditioning 9 Dewatering 10 Monitoring well 11 Injection well 12 Other (Specify below)
 Was a chemical/bacteriological sample submitted to Department? Yes _____ No _____; If yes, mo/day/yr sample was submitted
 Water Well Disinfected? Yes X No

5] TYPE OF BLANK CASING USED:
 1 Steel 2 PVC 3 RMP (SR) 4 ABS 5 Wrought iron 6 Asbestos-Cement 7 Fiberglass 8 Concrete tile 9 Other (specify below)
 CASING JOINTS: Glued X Clamped _____ Welded X Threaded _____
 Blank casing diameter: 10" in. to 0-67 ft., Dia _____ in. to _____ ft., Dia _____ in. to _____ ft.
 Casing height above land surface: _____ in., weight 40 lb. lbs./ft. Wall thickness or gauge No. 365

TYPE OF SCREEN OR PERFORATION MATERIAL:
 1 Steel 2 Brass 3 Stainless steel 4 Galvanized steel 5 Gauzed wrapped 6 Wire wrapped 7 PVC 8 RMP (SR) 9 ABS 10 Asbestos-cement 11 Other (specify) 12 None used (open hole)
 SCREEN OR PERFORATION OPENINGS ARE:
 1 Continuous slot 2 Louvered shutter 3 Mill slot 4 Key punched 5 Gauzed wrapped 6 Wire wrapped 7 Torch cut 8 Saw cut 9 Drilled holes 10 Other (specify) 11 None (open hole)

SCREEN-PERFORATED INTERVALS: From 67 ft. to 77 ft., From _____ ft. to _____ ft.
 GRAVEL PACK INTERVALS: From 38 ft. to 77 ft., From _____ ft. to _____ ft.

6] GROUT MATERIAL: 1 Neat cement 2 Cement grout 3 Bentonite 4 Other _____
 Grout Intervals: From 5 ft. to 36' ft., From _____ ft. to _____ ft., From _____ ft. to _____ ft.
 What is the nearest source of possible contamination: City owned land
 1 Septic tank 2 Sewer lines 3 Watertight sewer lines 4 Lateral lines 5 Cess pool 6 Seepage pit 7 Pit privy 8 Sewage lagoon 9 Feedyard 10 Livestock pens 11 Fuel storage 12 Fertilizer storage 13 Insecticide storage 14 Abandoned water well 15 Oil well/Gas well 16 Other (specify below)

Direction from well? _____ How many feet? _____

FROM	TO	LITHOLOGIC LOG	FROM	TO	PLUGGING INTERVALS
0	28	Fine Sand-Silty-Brown			
28	35	Clay-Brown-Silty			
35	50	Fine Sand-Brown-Silty			
50	58	Fine Sand-Brown-Silty-Clay-Brown			
58	60	Clay-Brown-Silty			
60	67	Fine Sand-Silty-Brown			
67	68	Fine Sand-Coarse Sand-Med-Gravel, Brown			
68	69	Boulders			
69	71	Fine Sand-Coarse Sand-Med-Gravel-Brown			
71	72	Clay-Brown			
72	77	Fine Sand-Coarse Sand-Med-some pea gravel-Brown-dirty			

7] CONTRACTOR'S OR LANDOWNER'S CERTIFICATION: This water well was (1) constructed, (2) reconstructed, or (3) plugged under my jurisdiction and was completed on (mo/day/year) 7-31-92 and this record is true to the best of my knowledge and belief. Kansas Water Well Contractor's License No. 182 This Water Well Record was completed on (mo/day/yr) 8-10-92 under the business name of STRADER DRILLING CO., INC. by (signature) Dalishoren