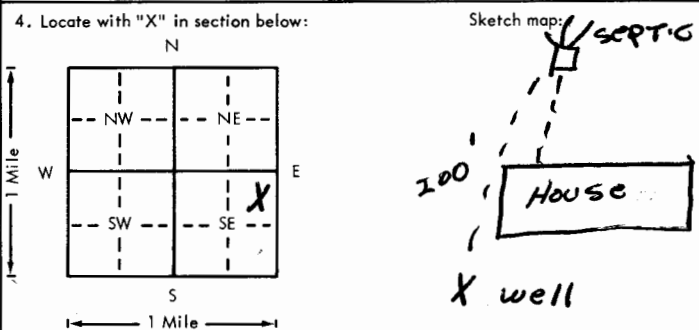


USE TYPEWRITER OR BALL POINT PEN-PRESS FIRMLY, PRINT CLEARLY.

WATER WELL RECORD
KSA 82a-1201-1215

Kansas Department of Health and Environment-Division of Environment
(Water well Contractors)
Topeka, Kansas 66620

1. Location of well: County POTTAWATOMIE		Fraction NE 1/4 NE 1/4 SE 1/4		Section number 10	Township number T 10 S R 9 E W	Range number
2. Distance and direction from nearest town or city: 1 E OF ST. GEORGE				3. Owner of well: GARY SMITH R.R. or street: RR. City, state, zip code: RANDOLPH, KS 66554		
4. Locate with "X" in section below: 				6. Bore hole dia. 12 in. Completion date 9-8-78 Well depth 160 ft.		
				7. <input checked="" type="checkbox"/> Cable tool <input checked="" type="checkbox"/> Rotary <input type="checkbox"/> Driven <input type="checkbox"/> Dug <input type="checkbox"/> Hollow rod <input type="checkbox"/> Jetted <input type="checkbox"/> Bored <input type="checkbox"/> Reverse rotary		
				8. Use: <input checked="" type="checkbox"/> Domestic <input type="checkbox"/> Public supply <input type="checkbox"/> Industry <input type="checkbox"/> Irrigation <input type="checkbox"/> Air conditioning <input type="checkbox"/> Stock <input type="checkbox"/> Lawn <input type="checkbox"/> Oil field water <input type="checkbox"/> Other		
				9. Casing: Material PVC Height: <input checked="" type="checkbox"/> Above or below Threaded <input type="checkbox"/> Welded <input type="checkbox"/> Surface 29 in. RMP <input type="checkbox"/> PVC 94 Weight 2.58 lbs./ft. Dia. 5 in. to 160 ft. depth Wall Thickness: inches or Dia. <input type="checkbox"/> in. to <input type="checkbox"/> ft. depth Gage No. 1274		
5. Type and color of material				From	To	10. Screen: Manufacturer's name PUMPCO MPI Type PVC Dia. 5 <input checked="" type="checkbox"/> Slot gauze 1020 Length 130 Set between 30 ft. and 160 ft. ft. and <input type="checkbox"/> ft. Gravel pack? <input checked="" type="checkbox"/> Size range of material 10-20/30
Top Soil				0	7	11. Static water level: <input type="checkbox"/> mo./day/yr. 55 ft. below land surface Date 9-8-78
FINE SAND				7	37	12. Pumping level below land surfaces: ft. after <input type="checkbox"/> hrs. pumping <input type="checkbox"/> g.p.m. ft. after <input type="checkbox"/> hrs. pumping <input type="checkbox"/> g.p.m. Estimated maximum yield 1 g.p.m.
Shale, grey				37	98	13. Water sample submitted: <input type="checkbox"/> Yes <input checked="" type="checkbox"/> No Date <input type="checkbox"/>
Limestone, grey				98	115	14. Well head completion: CAP <input type="checkbox"/> Pitless adapter 29 Inches above grade
shale, grey, red				115	160	15. Well grouted? <input checked="" type="checkbox"/> With: <input checked="" type="checkbox"/> Neat cement <input type="checkbox"/> Bentonite <input type="checkbox"/> Concrete Depth: From 5 ft. to 15 ft.
						16. Nearest source of possible contamination: ft. 200 Direction S Type SEPTIC Well disinfected upon completion? <input checked="" type="checkbox"/> Yes <input type="checkbox"/> No
						17. Pump: <input checked="" type="checkbox"/> Not installed Manufacturer's name _____ Model number _____ HP _____ Volts _____ Length of drop pipe _____ ft. capacity _____ g.p.m. Type: <input type="checkbox"/> Submersible <input type="checkbox"/> Turbine <input type="checkbox"/> Jet <input type="checkbox"/> Reciprocating <input type="checkbox"/> Centrifugal <input type="checkbox"/> Other
(Use a second sheet if needed)						20. Water well contractor's certification: This well was drilled under my jurisdiction and this report is true to the best of my knowledge and belief. Strader Delq Co 182 Business name License No. Address RT 1 Holton, KS Signed Dale Rubin Date 9-11-78 Authorized representative
18. Elevation: Topography: <input checked="" type="checkbox"/> Hill <input type="checkbox"/> Slope <input type="checkbox"/> Upland <input type="checkbox"/> Valley		19. Remarks: OWNER TO INSTALL SLAB				

T 10 S R 9 E W
Sec 10 NE 1/4 SE 1/4