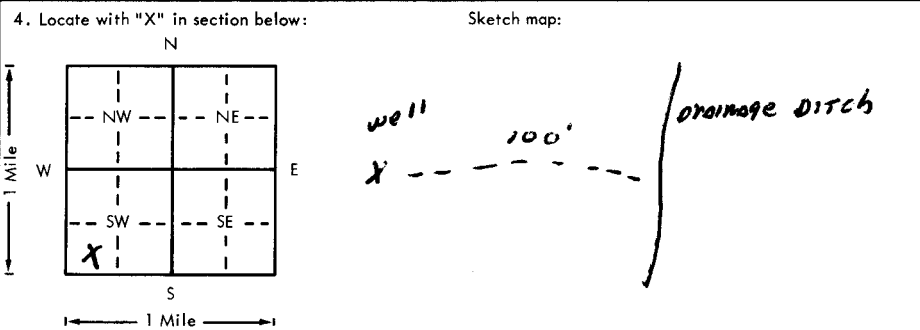


USE TYPEWRITER OR BALL POINT PEN-PRESS FIRMLY, PRINT CLEARLY.

WATER WELL RECORD
KSA 82a-1201-1215

Kansas Department of Health and Environment-Division of Environment
(Water well Contractors)
Topeka, Kansas 66620

1. Location of well:		County POTAWATOMIE	Fraction SW 1/4 SW 1/4 SW 1/4	Section number 11	Township number T 10 9	Range number R 9 E W
2. Distance and direction from nearest town or city: 1.5 E OF Street address of well location if in city: ST George			3. Owner of well: Jess ESTES R.R. or street: RT 1 City, state, zip code: Wamego, KS 66547			
4. Locate with "X" in section below: 			6. Bore hole dia. 12 in. Completion date 3-21-79 Well depth 50 ft.			
5. Type and color of material			7. <input checked="" type="checkbox"/> Cable tool <input checked="" type="checkbox"/> Rotary <input type="checkbox"/> Driven <input type="checkbox"/> Dug <input type="checkbox"/> Hollow rod <input type="checkbox"/> Jetted <input type="checkbox"/> Bored <input type="checkbox"/> Reverse rotary			
			8. Use: <input checked="" type="checkbox"/> Domestic <input type="checkbox"/> Public supply <input type="checkbox"/> Industry <input type="checkbox"/> Irrigation <input type="checkbox"/> Air conditioning <input type="checkbox"/> Stock <input type="checkbox"/> Lawn <input type="checkbox"/> Oil field water <input type="checkbox"/> Other			
			9. Casing: Material PVC Height: above or below Threaded <input type="checkbox"/> Welded <input type="checkbox"/> Surface 29 in. RMP <input type="checkbox"/> PVC 96 Weight 2.82 lbs./ft. Dia. 5 in. to 50 ft. depth Wall Thickness: inches or Dia. <input type="checkbox"/> in. to <input type="checkbox"/> ft. depth gage No. 258			
			10. Screen: Manufacturer's name PUMP CO MPI Type PVC Dia. 5 Slab/gauze 1020 Length 30 Set between 22 ft. and 92 ft. ft. and <input type="checkbox"/> ft. Gravel pack? <input checked="" type="checkbox"/> Size range of material 10/20 X 160			
			11. Static water level: <input type="checkbox"/> mo./day/yr. 20 ft. below land surface Date 3-21-79			
			12. Pumping level below land surfaces: ft. after <input type="checkbox"/> hrs. pumping <input type="checkbox"/> g.p.m. ft. after <input type="checkbox"/> hrs. pumping <input type="checkbox"/> g.p.m. Estimated maximum yield 8 g.p.m.			
			13. Water sample submitted: <input type="checkbox"/> mo./day/yr. <input type="checkbox"/> Yes <input checked="" type="checkbox"/> No Date <input type="checkbox"/>			
			14. Well head completion: cap <input type="checkbox"/> Pitless adapter 24 inches above grade			
			15. Well grouted? <input checked="" type="checkbox"/> With: <input checked="" type="checkbox"/> Neat cement <input type="checkbox"/> Bentonite <input type="checkbox"/> Concrete Depth: From 5 ft. to 15 ft.			
			16. Nearest source of possible contamination: ft. 100 Direction E Type Drainage Well disinfected upon completion? <input checked="" type="checkbox"/> Yes <input type="checkbox"/> No			
			17. Pump: <input checked="" type="checkbox"/> Not installed Manufacturer's name <input type="checkbox"/> Model number <input type="checkbox"/> HP <input type="checkbox"/> Volts <input type="checkbox"/> Length of drop pipe <input type="checkbox"/> ft. capacity <input type="checkbox"/> g.p.m. Type: <input type="checkbox"/> Submersible <input type="checkbox"/> Turbine <input type="checkbox"/> Jet <input type="checkbox"/> Reciprocating <input type="checkbox"/> Centrifugal <input type="checkbox"/> Other			
			(Use a second sheet if needed)			
18. Elevation: Topography: <input type="checkbox"/> Hill <input type="checkbox"/> Slope <input type="checkbox"/> Upland <input checked="" type="checkbox"/> Valley		19. Remarks: owner to install slab		20. Water well contractor's certification: This well was drilled under my jurisdiction and this report is true to the best of my knowledge and belief. Strader Dalg Co 182 Business name License No. Address RT 1 Holton, KS Signed Dale Osborn Date 3-21-79 Authorized representative		

Forward the white, blue and pink copies to the Department of Health and Environment

Form WWC-5