USE TYPEWRITER OR BALL POINT PEN-PRESS FIRMLY, PRINT CLEARLY.

WATER WELL RECORD
KSA 82a-1201-1215

Kansas Department of Health and Environment-Division of Environment
(Water well Contractors)
Topeka, Kansas 66620

1. Location of well: County: Pottawatomie | Fraction: NW 1/4 NW 1/4 NE 1/4 | Section number: 12 | Township number: T 10 S | Range number: R 9 E/W

2. Distance and direction from nearest town or city: 4 W 1.5 S
Street address of well location if in city: of Wamego

3. Owner of well: Milton Toy
R.F.D. or street: RT. 5
City, state, zip code: Manhattan, Ks 66502

4. Locate with "X" in section below:

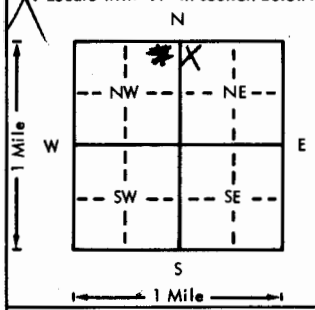

Sketch map:

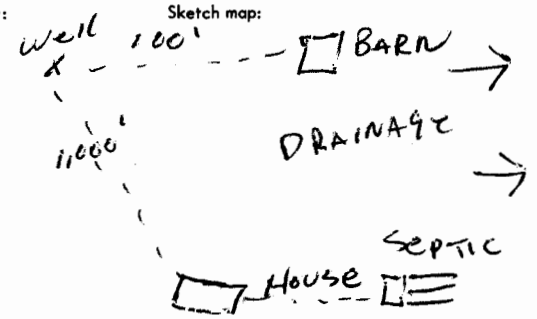

6. Bore hole dia. 12 in. Completion date
Well depth 95 ft. 5-7-76

7. Cable tool ✓ Rotary Driven Dug
Hollow rod Jetted Bored Reverse rotary

8. Use: ✓ Domestic Public supply Industry
Irrigation Air conditioning Stock
Lawn Oil field water Other

9. Casing: Material PVC | Height: (Above) or below
Threaded Welded | Surface 24 in.
RMP PVC GL | Weight 2.58 lbs./ft.
Dia. 5 in. to 95 ft. depth | Wall Thickness: inches or
Dia. in. to ft. depth | gage No. 1268

10. Screen: Manufacturer's name Pumpco
Type PVC Dia. 5
(Slot)/gauze .020 Length X 10'
Set between X 47 ft. and X 57 ft.
ft. and ft.
Gravel pack? ✓ Size range of material .030.060

11. Static water level: mo./day/yr.
40 ft. below land surface Date 5-7-76

12. Pumping level below land surfaces: Air Test
ft. after hrs. pumping g.p.m.
ft. after hrs. pumping g.p.m.
Estimated maximum yield 10 g.p.m.

13. Water sample submitted: mo./day/yr.
Yes ✓ No Date

14. Well head completion: Capped
Pitless adapter 24 Inches above grade

15. Well grouted? ✓
With: ✓ Neat cement Bentonite Concrete
Depth: From 0 ft. to 10 ft.

16. Nearest source of possible contamination:
ft. 100 Direction E Type lots
Well disinfected upon completion? ✓ Yes No

17. Pump: ✓ Not installed
Manufacturer's name
Model number HP Volts
Length of drop pipe ft. capacity g.p.m.
Type:
Submersible Turbine
Jet Reciprocating
Centrifugal Other

5. Type and color of material	From	To
Top Soil	0	5
Brown Clay	5	30
Fine Sand	30	57
grey shale	57	70
grey Lime	70	76
Blue shale	76	95

(Use a second sheet if needed)

18. Elevation:

Topography:
✓ Hill
Slope
Upland
Valley

19. Remarks: owner will install slab

20. Water well contractor's certification:
This well was drilled under my jurisdiction and this report is true to the best of my knowledge and belief.
Straden Drlg Co Inc 182
Business name License No.
Address RT 1 Holton, Ks
Signed Dale Akerson Date 5-10-76
Authorized representative

Forward the white, blue and pink copies to the Department of Health and Environment

Form WWC-5

1C 9E 12 NWNWNE
T R W Sec 1/4 1/4 1/4

MI-1023