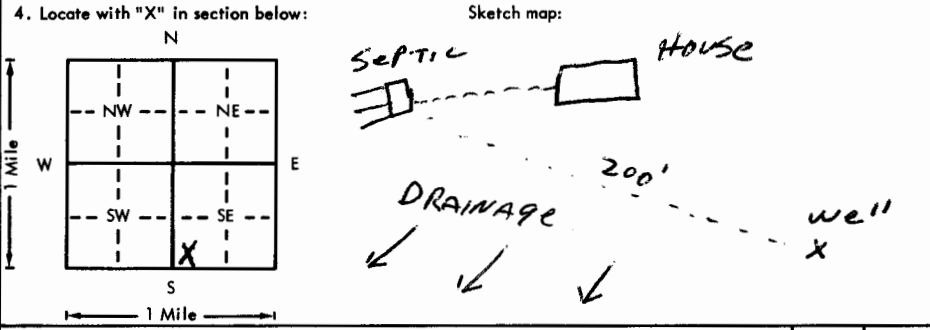


USE TYPEWRITER OR BALL POINT PEN-PRESS FIRMLY, PRINT CLEARLY.

WATER WELL RECORD
KSA 82a-1201-1215

Kansas Department of Health and Environment-Division of Environment
(Water well Contractors)
Topeka, Kansas 66620

1. Location of well: County POITAWATOMIE Fraction SW 1/4 SW 1/4 SE 1/4 Section number 12 Township number T 10 S R 9 Range number 9 E/W	
2. Distance and direction from nearest town or city: 3 W 1 S Street address of well location if in city: OF WAMEGO	
3. Owner of well: ELBERT SPAIN R.R. or street: City, state, zip code: MANHATTAN, KS	
4. Locate with "X" in section below: Sketch map: 	
5. Type and color of material	
	From To
TOP SOIL	0 5
FINE SAND	5 32
YELLOW SHALE	32 48
LOOSE LIME	48 51
GREY SHALE	51 87
GREY LIME	87 89
GREY SHALE	89 100
(Use a second sheet if needed)	
18. Elevation:	19. Remarks: OWNER WILL INSTALL SLAB
20. Water well contractor's certification: This well was drilled under my jurisdiction and this report is true to the best of my knowledge and belief. STRADER DRILG Co Inc 182 Business name License No. Address RT 1 HOLTON, KS Signed Dale Arthur Date 5-10-76 Authorized representative	

6. Bore hole dia. 10 in. Completion date 5-8-76 Well depth 100 ft.
7. <input checked="" type="checkbox"/> Cable tool <input checked="" type="checkbox"/> Rotary <input type="checkbox"/> Driven <input type="checkbox"/> Dug <input type="checkbox"/> Hollow rod <input type="checkbox"/> Jetted <input type="checkbox"/> Bored <input type="checkbox"/> Reverse rotary
8. Use: <input checked="" type="checkbox"/> Domestic <input type="checkbox"/> Public supply <input type="checkbox"/> Industry <input type="checkbox"/> Irrigation <input type="checkbox"/> Air conditioning <input type="checkbox"/> Stock <input type="checkbox"/> Lawn <input type="checkbox"/> Oil field water <input type="checkbox"/> Other
9. Casing: Material PVC Height: Above or below Threaded <input type="checkbox"/> Welded <input type="checkbox"/> Surface 24 in. RMP PVC 9L Weight 2.58 lbs./ft. Dia. 5 in. to 100 ft. depth Wall Thickness: inches or Dia. <input type="checkbox"/> in. to <input type="checkbox"/> ft. depth gage No. 228
10. Screen: Manufacturer's name PUMPCO Type PVC Dia. 5" Slot/gauze .025 Length 20 Set between 40 ft. and 60 ft. Gravel pack? <input checked="" type="checkbox"/> Size range of material 0.30 to 0.60
11. Static water level: 40 ft. below land surface Date 5-8-76 mo./day/yr.
12. Pumping level below land surfaces: AIR TEST <input type="checkbox"/> ft. after <input type="checkbox"/> hrs. pumping <input type="checkbox"/> g.p.m. <input type="checkbox"/> ft. after <input type="checkbox"/> hrs. pumping <input type="checkbox"/> g.p.m. Estimated maximum yield 50 g.p.m.
13. Water sample submitted: <input checked="" type="checkbox"/> Yes <input type="checkbox"/> No Date
14. Well head completion: CAPIED <input type="checkbox"/> Pitless adapter 24 inches above grade
15. Well grouted? <input checked="" type="checkbox"/> With: <input checked="" type="checkbox"/> Neat cement <input type="checkbox"/> Bentonite <input type="checkbox"/> Concrete Depth: From 0 ft. to 10 ft.
16. Nearest source of possible contamination: 200 ft. Direction W Type SEPTIC Well disinfected upon completion? <input type="checkbox"/> Yes <input type="checkbox"/> No
17. Pump: <input checked="" type="checkbox"/> Not installed Manufacturer's name _____ HP _____ Volts _____ Length of drop pipe _____ ft. capacity _____ g.p.m. Type: <input type="checkbox"/> Submersible <input type="checkbox"/> Turbine <input type="checkbox"/> Jet <input type="checkbox"/> Reciprocating <input type="checkbox"/> Centrifugal <input type="checkbox"/> Other
20. Water well contractor's certification: This well was drilled under my jurisdiction and this report is true to the best of my knowledge and belief. STRADER DRILG Co Inc 182 Business name License No. Address RT 1 HOLTON, KS Signed Dale Arthur Date 5-10-76 Authorized representative

T 10 S R 9 E
SW SW SE
1/4 1/4 1/4