WATER WELL RECORD Form WWC-5 KSA 82a-1212

1 LOCATION OF WATER WELL: County: Pottawatomie | Fraction: SW [redacted] ¼ NW ¼ SE ¼ | Section Number: [redacted] 14 | Township Number: T 10 S | Range Number: R 9 [redacted] E/W

Distance and direction from nearest town or city? [redacted] mi. W of Wamego on old Hwy 24 & 1/2 mi. S | Street address of well if located within city?

2 WATER WELL OWNER: William J. Taylor
RR#, St. Address, Box # : Rt. 1
City, State, ZIP Code : Wamego, KS

REDRILL 20' West of Orginal Well
Board of Agriculture, Division of Water Resources
Application Number: #4549 REDRILL

3 DEPTH OF COMPLETED WELL 69 [redacted] ft. Bore Hole Diameter 32 in. to 69 [redacted] ft., and ..... in. to ..... ft.

Well Water to be used as: 1 Domestic 3 Feedlot 2 Irrigation 4 Industrial 5 Public water supply 6 Oil field water supply 7 Lawn and garden only 8 Air conditioning 9 Dewatering 10 Observation well 11 Injection well 12 Other (Specify below)

Well's static water level 15 ft. below land surface measured on 8 month 9 day 83 year

Pump Test Data: Well water was 27 ft. after 1 hours pumping 1000 gpm
Est. Yield 1200 gpm: Well water was 29 ft. after 1 hours pumping 1000 gpm

4 TYPE OF BLANK CASING USED: 1 Steel 2 PVC 3 RMP (SR) 4 ABS 5 Wrought iron 6 Asbestos-Cement 7 Fiberglass 8 Concrete tile 9 Other (specify below)

Casing Joints: Glued ..... Clamped X Welded ..... Threaded .....

Blank casing dia 16 in. to 54 [redacted] ft., Dia ..... in. to ..... ft., Dia ..... in. to ..... ft.

Casing height above land surface 12 in., weight 23.7 lbs./ft. Wall thickness or gauge No .762

TYPE OF SCREEN OR PERFORATION MATERIAL: 1 Steel 2 Brass 3 Stainless steel 4 Galvanized steel 5 Fiberglass 6 Concrete tile 7 PVC 8 RMP (SR) 9 ABS 10 Asbestos-cement 11 Other (specify) 12 None used (open hole)

Screen or ~~Perforation~~ Openings Are: 1 Continuous slot 2 Louvered shutter 3 Mill slot 4 Key punched 5 Gauzed wrapped 6 Wire wrapped 7 Torch cut 8 Saw cut 9 Drilled holes 10 Other (specify) 11 None (open hole)

Screen-Perforation Dia [redacted] 16 in. to ..... ft., Dia ..... in. to ..... ft., Dia ..... in to ..... ft.

Screen-Perforated Intervals: From 54 ft. to 69 ft., From ..... ft. to ..... ft.
From ..... ft. to ..... ft., From ..... ft. to ..... ft.

Gravel Pack Intervals: From 10 ft. to 69 ft., From ..... ft. to ..... ft.
From ..... ft. to ..... ft., From ..... ft. to ..... ft.

6 GROUT MATERIAL: 1 Neat cement 2 Cement grout 3 Bentonite 4 Other .....

Grouted Intervals: From 0 ft. to 10 ft., From ..... ft. to ..... ft., From ..... ft. to ..... ft.

What is the nearest source of possible contamination: 1 Septic tank 2 Sewer lines 3 Lateral lines 4 Cess pool 5 Seepage pit 6 Pit privy 7 Sewage lagoon 8 Feed yard 9 Livestock pens 10 Fuel storage 11 Fertilizer storage 12 Insecticide storage 13 Watertight sewer lines 14 Abandoned water well 15 Oil well/Gas well 16 Other (specify below) NONE

Direction from well ..... How many feet ..... ? Water Well Disinfected? Yes ..... No X

Was a chemical/bacteriological sample submitted to Department? Yes ..... No X ..... If yes, date sample was submitted ..... month ..... day ..... year: Pump Installed? Yes ..... No X

If Yes: Pump Manufacturer's name ..... Model No. ..... HP ..... Volts .....

Depth of Pump Intake ..... ft. Pumps Capacity rated at ..... gal./min.

Type of pump: 1 Submersible 2 Turbine 3 Jet 4 Centrifugal 5 Reciprocating 6 Other

7 CONTRACTOR'S OR LANDOWNER'S CERTIFICATION: This water well was (1) constructed, (2) reconstructed, or (3) plugged under my jurisdiction and was completed on August month 7 day 1983 year and this record is true to the best of my knowledge and belief. Kansas Water Well Contractor's License No. 323

This Water Well Record was completed on August month 21 day 1983 year under the business name of Hoobler Drilling Company by (signature) Daniel F Hoobler

8 LOCATE WELL'S LOCATION WITH AN "X" IN SECTION BOX:

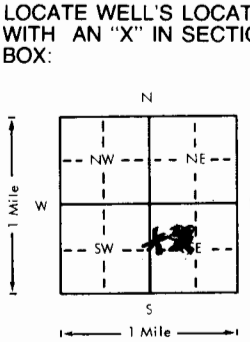

ELEVATION:

FROM	TO	LITHOLOGIC LOG	FROM	TO	LITHOLOGIC LOG
0	7	Fn brn sandy silt		19 69	green shale STOPPED
7	15	Fn brn sand			
15	27	sml-med brn gravel			
27	38	fn brn sand			
38	42	med brn gravel			
42	53	med-lg brn gravel			
53	57	fn brn sand			
57	60	sml-med brn gravel			
60	63	med-lg brn gravel			
63	64	sml-med green gravel			
64	69	lg green gravel			

Depth(s) Groundwater Encountered 1. ..... ft. 2. ..... ft. 3. ..... ft. 4. ..... ft. (Use a second sheet if needed)

INSTRUCTIONS: Use typewriter or ball point pen, *please press firmly* and *PRINT* clearly. Please fill in blanks, underline or circle the correct answers. Send top three copies to Kansas Department of Health and Environment, Division of Environment, Water Well Contractors, Topeka, KS 66620. Send one to WATER WELL OWNER and retain one for your records.

OFFICE USE ONLY T 10 R 9 E/W SEC. 14 SW¼ NW¼ SE¼