

County: Riley Fraction: SE SE NW Sec. 16 T. 10 S R. 9 E

CORRECTION(S) to WATER WELL COMPLETION RECORD Form WWC-5 (to rectify lacking or incorrect information)

Owner: Larry Hoobler

If location corrected, was listed as:

Section-Township-Range: S10-T9-R20

Fraction (1/4 calls): NW NW

Location changed to:

S16-T10-R9E

SE SE NW

Other changes: Initial statements: _____

The WWC5 has the incorrect address of 1239 Shady Land Rd

Changed to: Changed address to 1239 Sandy Land Rd

Comments: Called Leonard Backhoe service to verify information

Verification method: Located property using Riley County parcel search. Spoke with driller to verify location. Used KGS mapper to validate address with STR

Initials: SH Date: 02/02/2021

Submitted by: Kansas Geological Survey, Data Resources Library, 1930 Constant Ave., Lawrence, KS 66047-3724


Kansas Dept. of Health & Environment, Bureau of Water, 1000 SW Jackson, Suite 420, Topeka, KS 66612-1367

WATER WELL PLUGGING RECORD Form WWC-5P KSA 82a-1212 ID NO.

1 LOCATION OF WATER WELL: County: Riley Fraction NW 1/4 NW 1/4 Section Number 10 Township Number T 9 S Range Number 20 E W

Street/Rural Address of Well Location: if unknown, distance & direction from nearest town or intersection: If at owner's address, check here 3. E. Larry Hoover 1239 Shady Land Rd Manhattan KS 66502
 Global Positioning Systems (GPS) information:
 Latitude: _____ (in decimal degrees)
 Longitude: _____ (in decimal degrees)
 Elevation: _____
 Horizontal Datum: WGS84, NAD83, NAD27
 Collection Method: _____
 GPS unit (Make/Model: _____)
 Digital Map/Photo, Topographic Map, Land Survey
 Est. Accuracy: < 3 m, 3-5 m, 5-15 m, > 15 m

2 WATER WELL OWNER:
 RR#, St. Address, Box #: Larry Hoover 1239 Shady Land Rd
 City, State ZIP Code: Manhattan KS

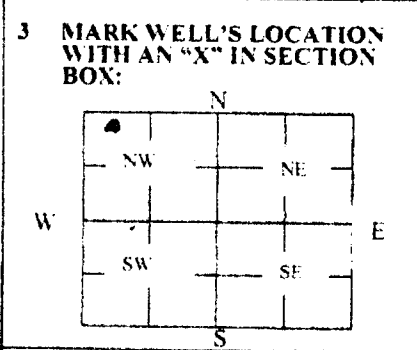

4 DEPTH OF WELL 52' ft.
WELL'S STATIC WATER LEVEL 17' ft.
WELL WAS USED AS:
 Domestic Public Water Supply Dewatering
 Irrigation Oil Field Water Supply Monitoring
 Feedlot Domestic (Lawn & Garden) Injection Well
 Industrial Air Conditioning Other _____
 Was a chemical/bacteriological sample submitted to Department? Yes No

5 TYPE OF BLANK CASING USED:
 Steel RMP (SR) Wrought Fiberglass Other (Specify below)
 PVC ABS Asbestos-Cement Concrete Tile
 Blank casing diameter 5 in. Was casing pulled? Yes No If yes, how much _____
 Casing height above or below land surface 4' Below in.

6 GROUT PLUG MATERIAL: Neat cement Cement grout Bentonite Other _____
 Grout Plug Intervals: From 0 ft. to 4' ft., From 4' ft. to 8' ft., From 8 ft. to 52' ft.
 What is the nearest source of possible contamination:
 Septic tank Seepage pit Fuel storage Other (specify below)
 Sewer lines Pit privy Fertilizer storage
 Watertight sewer lines Sewage lagoon Insecticide storage
 Lateral lines Feedyard Abandoned water well Direction from well? _____
 Cess pool Livestock pens Oil well/Gas well How many feet? _____

| FROM | TO | PLUGGING MATERIALS | FROM | TO | PLUGGING MATERIALS |
|------|----|--------------------|------|----|--------------------|
| 0 | 4 | Dirt | | | |
| 4 | 8 | Bentonite | | | |
| 8 | 52 | Sand | | | |
| | | 1 Gallon Chlorine | | | |
| | | | | | |
| | | | | | |

7 CONTRACTOR'S OR LANDOWNER'S CERTIFICATION: This water well was plugged under my jurisdiction and was completed on (mo/day/year) 10/29/20 and this record is true to the best of my knowledge and belief. Kansas Water Well Contractor's License No. _____ This Water Well Record was completed on (mo/day/year) 10/29/20 under the business name of Lorwood Dewater Service/Larry Hoover by (signature) [Signature]

Send one white copy to Kansas Department of Health & Environment, Geology Section, 1000 SW Jackson Street, Ste. 420, Topeka, KS 66612-1367. Send one copy to WATER WELL OWNER and retain one for your records.
 Visit us at <http://www.kdheks.gov/waterwell/index.html> Telephone 785-296-5524.