


1 LOCATION OF WATER WELL: Fraction SW 1/4 SW 1/4 SW 1/4 Section Number 21 Township Number T 10 S Range Number R 9 E  
 County: Kiley

Distance and direction from nearest town or city street address of well if located within city? 5700 Zindale

2 WATER WELL OWNER: Rodney Holub  
 RR#, St. Address, Box #: 5700 Zindale  
 City, State, ZIP Code: Manhattan, KS 66502  
 Board of Agriculture, Division of Water Resources  
 Application Number:

3 LOCATE WELL'S LOCATION WITH AN "X" IN SECTION BOX: 4 DEPTH OF COMPLETED WELL 42 ft. ELEVATION: 425  
 AN "X" IN SECTION BOX: WAS 30

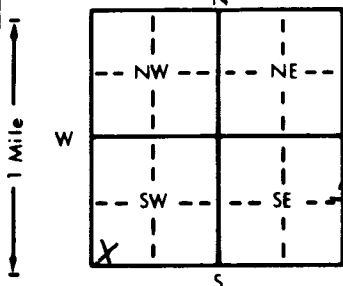

Depth(s) Groundwater Encountered WAS 30 ft. 3. ft.

WELL'S STATIC WATER LEVEL 30 ft. below land surface measured on mo/day/yr

Pump test data: Well water was plugged ft. after hours pumping gpm

Est. Yield gpm: Well water was plugged ft. after hours pumping gpm

Bore Hole Diameter ? in. to plugged ft. and in. to ft.

WELL WATER TO BE USED AS: 5 Public water supply 8 Air conditioning 11 Injection well

WAS 1 Domestic 3 Feedlot 6 Oil field water supply 9 Dewatering 12 Other (Specify below)

2 Irrigation 4 Industrial 7 Lawn and garden only 10 Monitoring well

Was a chemical/bacteriological sample submitted to Department? Yes No If yes, mo/day/yr sample was submitted

Water Well Disinfected? Yes No

5 TYPE OF BLANK CASING USED: 5 Wrought iron 8 Concrete tile CASING JOINTS: Glued Clamped

1 Steel 3 RMP (SR) 6 Asbestos-Cement 9 Other (specify below) Welded

2 PVC 4 ABS 7 Fiberglass Threaded

Blank casing diameter 5 1/2 in. to ft. Dia. Floor Level in. to ft. Dia. in. to ft.

Casing height above land surface Cut off at Basement Floor Level lbs./ft. Wall thickness or gauge No.

TYPE OF SCREEN OR PERFORATION MATERIAL: 7 PVC 10 Asbestos-cement

1 Steel 3 Stainless steel 5 Fiberglass 8 RMP (SR) 11 Other (specify) N/A

2 Brass 4 Galvanized steel 6 Concrete tile 9 ABS 12 None used (open hole)

SCREEN OR PERFORATION OPENINGS ARE: 5 Gauzed wrapped 8 Saw cut 11 None (open hole)

1 Continuous slot 3 Mill slot ? 6 Wire wrapped 9 Drilled holes

2 Louvered shutter 4 Key punched ? 7 Torch cut 10 Other (specify) N/A

SCREEN-PERFORATED INTERVALS: From ? ft. to ft. From ft. to ft.

From ft. to ft. From ft. to ft.

GRAVEL PACK INTERVALS: From ft. to ft. From ft. to ft.

From ft. to ft. From ft. to ft.

6 GROUT MATERIAL: 1 Neat cement 2 Cement grout 3 Bentonite 4 Other

Grout Intervals: From 0 ft. to 25 ft. From Enviroplug ft. to ft.

What is the nearest source of possible contamination: 10 Livestock pens 14 Abandoned water well

1 Septic tank 4 Lateral lines 7 Pit privy 11 Fuel storage 15 Oil well/Gas well

2 Sewer lines 5 Cess pool 8 Sewage lagoon 12 Fertilizer storage 16 Other (specify below)

3 Watertight sewer lines 6 Seepage pit 9 Feedyard 13 Insecticide storage HOUSE

Direction from well? WAS 90° North West How many feet? 70 termite control

FROM TO LITHOLOGIC LOG FROM TO PLUGGING INTERVALS

0 25 Bentonite Enviroplug

25 42 Chlorinated Sands