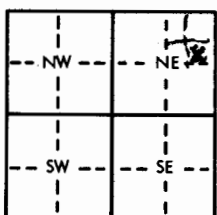
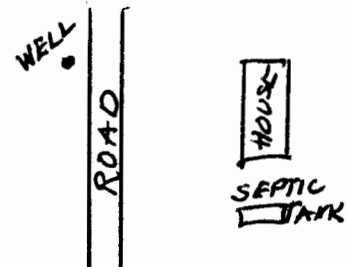


USE TYPEWRITER OR BALL
POINT PEN—PRESS FIRMLY,
PRINT CLEARLY.

WATER WELL RECORD
KSA 82g-1201-1215

Kansas Department of Health and
Environment-Division of Environment
(Water well Contractors)
Topeka, Kansas 66620

1. Location of well: Dickinson		Fraction SE 1/4 NE 1/4 NE 1/4		Section number 35		Township number T 11 S R 1		Range number 1		EW				
2. Distance and direction from nearest town or city: 8 miles north and 4 west of Abilene					3. Owner of well: Kenneth Bebermeyer R.R. or street: R.R. #4 City, state, zip code: Abilene, Kansas 67410									
4. Locate with "X" in section below: <div style="text-align: center;">N 1 Mile W E S 1 Mile</div> 					Sketch map: 					6. Bore hole dia. 8 in. Completion date 5/13/76 Well depth 55 ft.				
5. Type and color of material					From		To		7. <input checked="" type="checkbox"/> Cable tool <input type="checkbox"/> Rotary <input type="checkbox"/> Driven <input type="checkbox"/> Dug <input type="checkbox"/> Hollow rod <input type="checkbox"/> Jetted <input type="checkbox"/> Bored <input type="checkbox"/> Reverse rotary					
									8. Use: <input checked="" type="checkbox"/> Domestic <input type="checkbox"/> Public supply <input type="checkbox"/> Industry <input type="checkbox"/> Irrigation <input type="checkbox"/> Air conditioning <input type="checkbox"/> Stock <input type="checkbox"/> Lawn <input type="checkbox"/> Oil field water <input type="checkbox"/> Other					
									9. Casing: Material plst Height: Above 18 in. Threaded <input type="checkbox"/> Welded <input checked="" type="checkbox"/> Surface 18 in. RMP <input checked="" type="checkbox"/> PVC <input type="checkbox"/> Weight 18 lbs./ft. Dia. 5 in. to 55 ft. depth Well Thickness: inches or Dia. 5 in. to 55 ft. depth gauge No. 0.258					
									10. Screens: Manufacturer's name Western Plastics Type RMP Dia. 5" Slot/gauze 3/32 Length 12' Set between 43 ft. and 55 ft. Gravel pack? Yes Size range of material 1/16 to 3/16					
									11. Static water level: 29 ft. below land surface Date 5/13/76					
									12. Pumping level below land surfaces: ____ ft. after ____ hrs. pumping ____ g.p.m. ____ ft. after ____ hrs. pumping ____ g.p.m. Estimated maximum yield 16+ g.p.m.					
									13. Water sample submitted: ____ mo./day/yr. Yes <input checked="" type="checkbox"/> No <input type="checkbox"/> Date ____					
									14. Well head completion: 18 inches above grade Pitless adapter					
									<input checked="" type="checkbox"/> Well grouted? Yes With: <input type="checkbox"/> Neat cement <input type="checkbox"/> Bentonite <input checked="" type="checkbox"/> Concrete Depth: From 0 ft. to 10 ft.					
									16. Nearest source of possible contamination: septic tank ft. 500 Direction S.E. Type septic tank Well disinfected upon completion? <input checked="" type="checkbox"/> Yes <input type="checkbox"/> No					
									17. Pump: <input checked="" type="checkbox"/> Not installed Manufacturer's name ____ Model number ____ HP ____ Volts ____ Length of drop pipe ____ ft. capacity ____ g.p.m. Type: <input type="checkbox"/> Submersible <input type="checkbox"/> Turbine <input type="checkbox"/> Jet <input type="checkbox"/> Reciprocating <input type="checkbox"/> Centrifugal <input type="checkbox"/> Other					
									18. Elevation: ~1270 Topography: <input type="checkbox"/> Hill <input type="checkbox"/> Slope <input checked="" type="checkbox"/> Upland <input type="checkbox"/> Valley					
									19. Remarks: Concrete slab to be installed by customer at surface of ground.					
														20. Water well contractor's certification: This well was drilled under my jurisdiction and this report is true to the best of my knowledge and belief. Rader Drilling Co. 194 Business name Carlton, Kansas License No. 67429 Address Brant E. Rader Signed Brant E. Rader Authorized representative Date 6-2-76

Forward the white, blue and pink copies to the Department of Health and Environment

Form WWC-5