


WATER WELL RECORD Form WWC-5 KSA 82a-1212

1 LOCATION OF WATER WELL: County: Wabaunsee Fraction: SW 1/4 NE 1/4 NE 1/4 Section Number: 11 Township Number: T 11 S Range Number: R 10 EW

Distance and direction from nearest town or city street address of well if located within city?
6 South, 3/4 East, 1/4 South of Wamego

2 WATER WELL OWNER: Carl Brase
 RR#, St. Address, Box #: 211 Walnut Board of Agriculture, Division of Water Resources
 City, State, ZIP Code: Wamego, KS. 66547 Application Number:

3 LOCATE WELL'S LOCATION WITH AN "X" IN SECTION BOX:

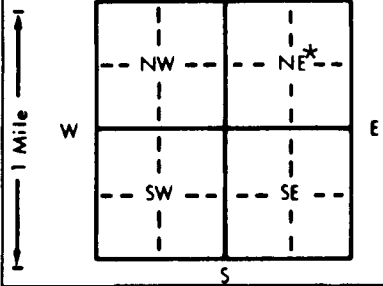

4 DEPTH OF COMPLETED WELL: 112' ft. ELEVATION:

Depth(s) Groundwater Encountered: 1. 80 ft. 2. 80 ft. 3. 80 ft.
 WELL'S STATIC WATER LEVEL: 80 ft. below land surface measured on mo/day/yr 6/19/97
 Pump test data: Well water was 5 ft. after 9 hours pumping 5 gpm
 Est. Yield: 5 gpm; Well water was 115 ft. after 9 hours pumping 115 gpm
 Bore Hole Diameter: 9 in. to 115 ft., and 9 in. to 115 ft.
 WELL WATER TO BE USED AS:
 1 Domestic 5 Public water supply 8 Air conditioning 11 Injection well
 2 Irrigation 3 Feedlot 6 Oil field water supply 9 Dewatering 12 Other (Specify below)
 4 Industrial 7 Lawn and garden only 10 Monitoring well
 Was a chemical/bacteriological sample submitted to Department? Yes No *; If yes, mo/day/yr sample was submitted No
 Water Well Disinfected? Yes No * No

5 TYPE OF BLANK CASING USED:
 1 Steel 3 RMP (SR) 5 Wrought iron 8 Concrete tile CASING JOINTS: Glued * Clamped
 2 PVC 4 ABS 6 Asbestos-Cement 9 Other (specify below) Welded
 7 Fiberglass Threaded

Blank casing diameter: 5 in. to 9.2 ft., Dia. 1.8 in. to 200 lbs./ft. Wall thickness or gauge No.
 Casing height above land surface: 1.8 in., weight 200 lbs./ft.

TYPE OF SCREEN OR PERFORATION MATERIAL:
 1 Steel 3 Stainless steel 5 Fiberglass 7 PVC 10 Asbestos-cement
 2 Brass 4 Galvanized steel 6 Concrete tile 8 RMP (SR) 11 Other (specify)
 9 ABS 12 None used (open hole)

SCREEN OR PERFORATION OPENINGS ARE:
 1 Continuous slot 3 Mill slot 5 Gauzed wrapped 8 Saw cut 11 None (open hole)
 2 Louvered shutter 4 Key punched 6 Wire wrapped 9 Drilled holes
 7 Torch cut 10 Other (specify)

SCREEN-PERFORATED INTERVALS: From 9.2 ft. to 112 ft., From 9.2 ft. to 112 ft.
 GRAVEL PACK INTERVALS: From 40 ft. to 112 ft., From 40 ft. to 112 ft.

6 GROUT MATERIAL: 1 Neat cement 2 Cement grout 3 Bentonite 4 Other
 Grout Intervals: From 5 ft. to 40 ft., From 5 ft. to 40 ft.

What is the nearest source of possible contamination:
 1 Septic tank 4 Lateral lines 7 Pit privy 10 Livestock pens 14 Abandoned water well
 2 Sewer lines 5 Cess pool 8 Sewage lagoon 11 Fuel storage 15 Oil well/Gas well
 3 Watertight sewer lines 6 Seepage pit 9 Feedyard 12 Fertilizer storage 16 Other (specify below)
 13 Insecticide storage
 Direction from well? West How many feet? 80

FROM	TO	LITHOLOGIC LOG	FROM	TO	PLUGGING INTERVALS
0	4	Brown Clay			
4	5	Rock			
5	15	Orange Clay			
15	20m	Tan Clay			
20	24	Light Gray Shale			
24	26	Red Shale			
26	36	Light Gray Shale			
36	49	Limestone Layers			
49	55	Black Shale			
55	60	Gray Shale			
60	95	Light Blue Shale			
95	97	Limestone			
97	115	Gray Shale			

7 CONTRACTOR'S OR LANDOWNER'S CERTIFICATION: This water well was (1) constructed, (2) reconstructed, or (3) plugged under my jurisdiction and was completed on (mo/day/year) 6/19/97 and this record is true to the best of my knowledge and belief. Kansas Water Well Contractor's License No. 518 This Water Well Record was completed on (mo/day/yr) 6/20/97 under the business name of Blue Valley Drilling by (signature) Carl Brase

INSTRUCTIONS: Use typewriter or ball point pen. PLEASE PRESS FIRMLY and PRINT clearly. Please fill in blanks, underline or circle the correct answers. Send top three copies to Kansas Department of Health and Environment, Bureau of Water, Topeka, Kansas 66620-0001. Telephone: 913-296-5545. Send one to WATER WELL OWNER and retain one for your records.