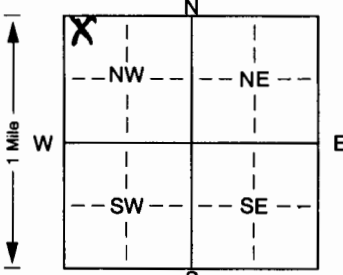


G06-25

WATER WELL RECORD Form WWC-5 KSA 82a-1212 ID No.

1 LOCATION OF WATER WELL: Fraction NW 1/4 NW 1/4 NW 1/4 Section Number 10 Township Number T 11 S Range Number R 10 W
 County: WABASH
 Distance and direction from nearest town or city street address of well if located within city?

2 WATER WELL OWNER: BRIAN LOGAN
 RR#, St. Address, Box #: 17135 Neff Rd Board of Agriculture, Division of Water Resources
 City, State, ZIP Code: WINTHROP, KS 66547 Application Number: _____

3 LOCATE WELL'S LOCATION WITH AN "X" IN SECTION BOX:

 4 DEPTH OF COMPLETED WELL: 290 ft. ELEVATION: _____
 Depth(s) Groundwater Encountered 1... 70 ft. 2... _____ ft. 3... _____ ft.
 WELL'S STATIC WATER LEVEL: _____ ft. below land surface measured on mo/day/yr _____
 Pump test data: Well water was _____ ft. after _____ hours pumping _____ gpm
 Est. Yield 20 gpm: Well water was _____ ft. after _____ hours pumping _____ gpm
 Bore Hole Diameter: 5.125 in. to 2.90 ft., and _____ in. to _____ ft.
 WELL WATER TO BE USED AS:
 5 Public water supply 8 Air conditioning 11 Injection well
 1 Domestic 3 Feedlot 6 Oil field water supply 9 Dewatering
 2 Irrigation 4 Industrial 7 Domestic (lawn & garden) 10 Monitoring well CLOSED LOOP GEOTHERMAL
 Was a chemical/bacteriological sample submitted to Department? Yes. _____ No. X; If used, mo/day/yr sample was submitted Water Well Disinfected? Yes _____ No X

5 TYPE OF BLANK CASING USED:
 1 Steel 3 RMP (SR) 5 Wrought iron 8 Concrete tile CASING JOINTS: Glued. _____ Clamped. _____
 2 PVC ABS 6 Asbestos-Cement 9 Other (specify below) Welded _____
 7 Fiberglass Threaded _____
 Blank casing diameter 3/4 in. to _____ ft., Dia _____ in. to _____ ft., Dia _____ in. to _____ ft.
 Casing height below land surface 7 in., weight _____ lbs./ft. Wall thickness or gauge No. _____
 TYPE OF SCREEN OR PERFORATION MATERIAL:
 1 Steel 3 Stainless steel 5 Fiberglass 7 PVC 10 Asbestos-cement
 2 Brass 4 Galvanized steel 6 Concrete tile 8 RMP (SR) 11 Other (specify) _____
 9 ABS 12 None used (open hole)
 SCREEN OR PERFORATION OPENINGS ARE:
 1 Continuous slot 3 Mill slot 5 Gauzed wrapped 8 Saw cut 11 None (open hole)
 2 Louvered shutter 4 Key punched 6 Wire wrapped 9 Drilled holes
 7 Torch cut 10 Other (specify) _____ ft.
 SCREEN-PERFORATED INTERVALS: From _____ ft. to _____ ft., From _____ ft. to _____ ft.
 From _____ ft. to _____ ft., From _____ ft. to _____ ft.
 GRAVEL PACK INTERVALS: From _____ ft. to _____ ft., From _____ ft. to _____ ft.
 From _____ ft. to _____ ft., From _____ ft. to _____ ft.

6 GROUT MATERIAL: 1 Neat cement 2 Cement grout 3 Bentonite 4 Other _____
 Grout Intervals: From 0 ft. to 240 ft., From _____ ft. to _____ ft., From _____ ft. to _____ ft.
 What is the nearest source of possible contamination:
 1 Septic tank 4 Lateral lines 7 Pit privy 10 Livestock pens 14 Abandoned water well
 2 Sewer lines 5 Cess pool 8 Sewage lagoon 11 Fuel storage 15 Oil well/Gas well
 3 Watertight sewer lines 6 Seepage pit 9 Feedyard 12 Fertilizer storage 16 Other (specify below)
HOME
 Direction from well? Below Basement Floor How many feet? 0

FROM	TO	LITHOLOGIC LOG	FROM	TO	PLUGGING INTERVALS
0	2	CLAY	202	240	SHALE, GRAY
2	4	LIMESTONE	240		TOTAL GRAY
4	16	SHALE, BROWN, RED, SHALE			
16	30	LIMESTONE			
30	65	SHALE, GRAY			
65	70	LIMESTONE			1-260
70	98	SHALE, BROWN TO GRAY TO BROWN			1-250
98	105	LIMESTONE			1-236
105	110	SHALE, BROWN			1-267
110	120	LIMESTONE			1-265
120	142	SHALE, GRAY			1-281
142	150	LIMESTONE			
150	190	SHALE, GRAY			
190	202	LIMESTONE			

7 CONTRACTOR'S OR LANDOWNER'S CERTIFICATION: This well was (1) constructed, (2) reconstructed, or (3) plugged under my jurisdiction and was completed on (mo/day/year) 9/14/01 and this record is true to the best of my knowledge and belief. Kansas Water Well Contractor's Licence No. 585 This Water Well Record was completed on (mo/day/yr) 9/19/01 under the business name of ASSOCIATED KANSAS WATER WELL CONTRACTORS INC. by (signature) _____