

**WATER WELL RECORD Form WWC-5**


Division of Water Resources App. No.  

Well ID  

Original Record  Correction  Change in Well Use

**1 LOCATION OF WATER WELL:** Fraction NW, NW, NW 1/4 Section Number 15 Township Number T 11 S Range Number R 10 E W

**2 WELL OWNER:** Last Name: Edds First: William Street or Rural Address where well is located (if unknown, distance and direction from nearest town or intersection): If at owner's address, check here:   
 Business Address: 923 North Lyndon From Wingo go south on 99th 6.5 miles  
 Address: ALMA State: KS ZIP: 66401 To Blairford Rd. then go west 1/2 mile  
 City: ALMA

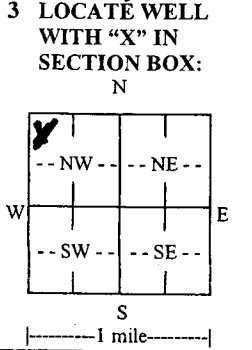

**4 DEPTH OF COMPLETED WELL:** 140 ft.  
 Depth(s) Groundwater Encountered: 1) 102 ft.  
 2) 90 ft. 3) 90 ft., or 4)  Dry Well  
 WELL'S STATIC WATER LEVEL: 90 ft.  
 below land surface, measured on (mo-day-yr) 9/9/2022  
 above land surface, measured on (mo-day-yr)    
 Pump test data: Well water was   ft. after   hours pumping   gpm  
 Well water was   ft. after   hours pumping   gpm  
 Estimated Yield: 20 gpm  
 Bore Hole Diameter: 9" in. to 140' ft. and   in. to   ft.

**5 Latitude:** N 39° 06.077 (decimal degrees)  
**Longitude:** W 096° 17.744 (decimal degrees)  
 Horizontal Datum:  WGS 84  NAD 83  NAD 27  
 Source for Latitude/Longitude:  GPS (unit make/model: Garmin ETRX 20)  
 (WAAS enabled?  Yes  No)  
 Land Survey  Topographic Map  
 Online Mapper:  

**6 Elevation:** 1,230' ft.  Ground Level  TOC  
 Source:  Land Survey  GPS  Topographic Map  
 Other  

**7 WELL WATER TO BE USED AS:**

1. Domestic:  Household  Lawn & Garden  Livestock  Irrigation  Feedlot  Industrial

2. Public Water Supply: well ID  

3. Dewatering: how many wells?  

4. Aquifer Recharge: well ID  

5. Monitoring: well ID  

6. Environmental Remediation: well ID  

7. Air Sparge  Soil Vapor Extraction  Recovery  Injection

8. Oil Field Water Supply: lease  

9. Test Hole: well ID  

10. Cased  Uncased  Geotechnical

11. Geothermal: how many bores?  

12. a) Closed Loop  Horizontal  Vertical  
 b) Open Loop  Surface Discharge  Inj. of Water

13. Other (specify):  

Was a chemical/bacteriological sample submitted to KDHE?  Yes  No  
 Water well disinfected?  Yes  No  
 If yes, date sample was submitted:  

**8 TYPE OF CASING USED:**  Steel  PVC  Other   CASING JOINTS:  Glued  Clamped  Welded  Threaded  
 Casing diameter 5" in. to 120' ft., Diameter   in. to   ft., Diameter   in. to   ft.  
 Casing height above land surface 3' in. Weight Sch. 40 lbs./ft. Wall thickness or gauge No.    
 TYPE OF SCREEN OR PERFORATION MATERIAL:  Steel  Stainless Steel  Fiberglass  PVC  Other (Specify)    
 Brass  Galvanized Steel  Concrete tile  None used (open hole)  
 SCREEN OR PERFORATION OPENINGS ARE:  
 Continuous Slot  Mill Slot  Gauze Wrapped  Torch Cut  Drilled Holes  Other (Specify)    
 Louvered Shutter  Key Punched  Wire Wrapped  Saw Cut  None (Open Hole)  
 SCREEN-PERFORATED INTERVALS: From 120 ft. to 140 ft., From   ft. to   ft., From   ft. to   ft.  
 GRAVEL PACK INTERVALS: From 30 ft. to 140 ft., From   ft. to   ft., From   ft. to   ft.

**9 GROUT MATERIAL:**  Neat cement  Cement grout  Bentonite  Other    
 Grout Intervals: From 5 ft. to 30 ft., From   ft. to   ft., From   ft. to   ft.  
 Nearest source of possible contamination: None Close  
 Septic Tank  Lateral Lines  Pit Privy  Livestock Pens  Insecticide Storage  
 Sewer Lines  Cess Pool  Sewage Lagoon  Fuel Storage  Abandoned Water Well  
 Watertight Sewer Lines  Seepage Pit  Feedyard  Fertilizer Storage  Oil Well/Gas Well  
 Other (Specify)    
 Direction from well?   Distance from well?   ft.

10 FROM	TO	LITHOLOGIC LOG	FROM	TO	LITHO. LOG (cont.) or PLUGGING INTERVALS
0	1	Top Soil	54	56	Limestone
1	6	Tan Clay	56	71	Grey shale
6	8	Limestone	71	74	Limestone
8	10	Yellow Shale	74	102	Maron Shale
10	11	Limestone	102	108	Limestone (Water)
11	28	Brown Shale	108	116	Grey Shale
28	37	Grey Shale	116	124	Limestone
37	46	Limestone	124	140	Grey Shale
46	54	Tan Shale			

**11 CONTRACTOR'S OR LANDOWNER'S CERTIFICATION:** This water well was  constructed,  reconstructed, or  plugged under my jurisdiction and was completed on (mo-day-year) 9/8/2022 and this record is true to the best of my knowledge and belief.  
 Kansas Water Well Contractor's license No. 451 This Water Well Record was completed on (mo-day-year) 9/9/2022  
 under the business name of Haldeman Well Drilling