

9

1/4 1/4 1/4 1/4

USE TYPEWRITER OR BALL POINT PEN-PRESS FIRMLY, PRINT CLEARLY.

CAB WATER WELL RECORD KSA 82a-1201-1215

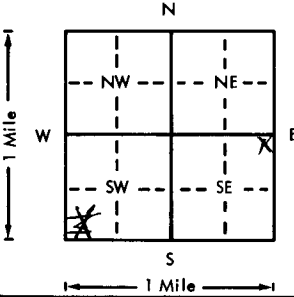
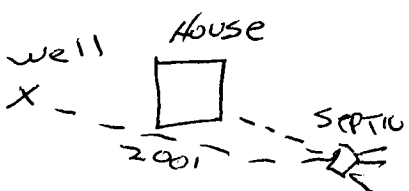
Kansas Department of Health and Environment-Division of Environment (Water well Contractors) Topeka, Kansas 66620

NW NE SW

1. Location of well: County Wabaunsee Fraction ~~SW 1/4 SW 1/4 SW 1/4~~ Section number 10 Township number T 11 S R 10 0 NW

2. Distance and direction from nearest town or city: 6 S of  
Street address of well location if in city: Wamego

3. Owner of well: Charles Gilman  
R.R. or street: 727 Lincoln  
City, state, zip code: Wamego, KS

4. Locate with "X" in section below: Sketch map:  



6. Bore hole dia. 8 in. Completion date 7-18-77  
Well depth 140 ft.

7.  Cable tool  Rotary  Driven  Dug  
 Hollow rod  Jetted  Bored  Reverse rotary

8. Use:  Domestic  Public supply  Industry  
 Irrigation  Air conditioning  Stock  
 Lawn  Oil field water  Other

9. Casing: Material PVC Height: Above or below  
Threaded  Welded  Surface 24 in.  
RMP PVC 9L Weight 2.58 lbs./ft.  
Dia. 5 in. to 140 ft. depth Well Thickness: inches or  
Dia.     in. to     ft. depth gage No. 258

5. Type and color of material

	From	To
<u>TOP SOIL</u>	<u>0</u>	<u>3</u>
<u>shale, grey</u>	<u>3</u>	<u>46</u>
<u>Lime, grey</u>	<u>47</u>	<u>52</u>
<u>shale, grey, red</u>	<u>52</u>	<u>78</u>
<u>Limestone, yellow</u>	<u>78</u>	<u>85</u>
<u>shale, grey, blk.</u>	<u>85</u>	<u>140</u>

10. Screen: Manufacturer's name MPI  
Type PVC Dia. 5  
slot gauze 1020 Length 40  
Set between 60 ft. and 100 ft.  
Gravel pack?  Size range of material: 030x060

11. Static water level: 80 ft. below land surface Date 7-18-77  
mo./day/yr.

12. Pumping level below land surfaces:  
    ft. after     hrs. pumping     g.p.m.  
    ft. after     hrs. pumping     g.p.m.  
Estimated maximum yield 10 g.p.m.

13. Water sample submitted:     mo./day/yr.  
Yes  No  Date    

14. Well head completion: CAP  
 Pitless adapter 24 inches above grade

15. Well grouted?   
With:  Neat cement  Bentonite  Concrete  
Depth: From 5 ft. to 15 ft.

16. Nearest source of possible contamination:  
ft. SE Direction 200 Type SEPTIC  
Well disinfected upon completion?  Yes  No

17. Pump:  Not installed  
Manufacturer's name      
Model number     HP     Valts      
Length of drop pipe     ft. capacity     g.p.m.  
Type:  
 Submersible  Turbine  
 Jet  Reciprocating  
 Centrifugal  Other

(Use a second sheet if needed)

18. Elevation: 1266  
Topography:  Hill  Slope  Upland  Valley

19. Remarks: OWNER TO INSTAL STAB

20. Water well contractor's certification:  
This well was drilled under my jurisdiction and this report is true to the best of my knowledge and belief.  
Strader Dalg Co Inc 182  
Business name License No.  
Address Holtan, KS  
Signed Dale Gilman Date 7-18-77  
Authorized representative

Forward the white, blue and pink copies to the Department of Health and Environment

Form WWC-5

BR = 1243

▽ = 1166

1/4 1/4 1/4 1/4