


1 LOCATION OF WATER WELL: Fraction $\frac{1}{4}$ NW $\frac{1}{4}$ SW $\frac{1}{4}$ Section Number 34 Township Number T 11 S Range Number R 10 E

Distance and direction from nearest town or city street address of well if located within city? From ALMA Go 2 Miles North on 99th Then Go 30 West on Township Road

2 WATER WELL OWNER: DON MRSCK
 RR#, St. Address, Box #: 227 EAST 9TH
 City, State, ZIP Code: ALMA, KANSAS 66401
 Board of Agriculture, Division of Water Resources
 Application Number:

3 LOCATE WELL'S LOCATION WITH AN "X" IN SECTION BOX:

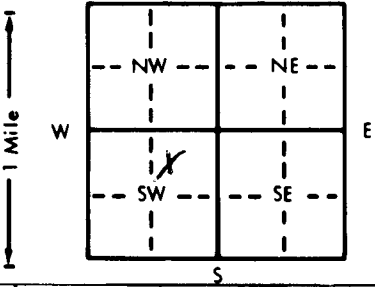

4 DEPTH OF COMPLETED WELL: 110' ft. ELEVATION: ... ft.

Depth(s) Groundwater Encountered 1. 20' ft. 2. ... ft. 3. ... ft.
 WELL'S STATIC WATER LEVEL: 75'-80' below land surface measured on mo/day/yr

Pump test data: Well water was ... ft. after ... hours pumping ... gpm
 Est. Yield: 10 gpm; Well water was ... ft. after ... hours pumping ... gpm
 Bore Hole Diameter: 8 in. to 110' ft., and ... in. to ... ft.

WELL WATER TO BE USED AS:
 1 Domestic (circled) 3 Feedlot 6 Oil field water supply 9 Dewatering 12 Other (Specify below)
 2 Irrigation 4 Industrial 7 Lawn and garden only 10 Observation well

Was a chemical/bacteriological sample submitted to Department? Yes ... No ...; If yes, mo/day/yr sample was submitted

5 TYPE OF BLANK CASING USED:
 1 Steel 3 RMP (SR) 5 Wrought iron 8 Concrete tile CASING JOINTS: Glued ... Clamped ...
 2 PVC (circled) 4 ABS 6 Asbestos-Cement 9 Other (specify below) Welded ... Screwed ...
 7 Fiberglass ... Threaded ...

Blank casing diameter: 5" in. to 110' ft., Dia ... in. to ... ft., Dia ... in. to ... ft.
 Casing height above land surface: 2' in., weight: 56.40 lbs./ft. Wall thickness or gauge No. ...

TYPE OF SCREEN OR PERFORATION MATERIAL:
 1 Steel 3 Stainless steel 5 Fiberglass 8 RMP (SR) 10 Asbestos-cement
 2 Brass 4 Galvanized steel 6 Concrete tile 9 ABS 11 Other (specify) ...
 12 None used (open hole)

SCREEN OR PERFORATION OPENINGS ARE:
 1 Continuous slot 3 Mill slot (circled) 5 Gauzed wrapped 8 Saw cut 11 None (open hole)
 2 Louvered shutter 4 Key punched 6 Wire wrapped 9 Drilled holes
 7 Torch cut 10 Other (specify) ...

SCREEN-PERFORATED INTERVALS: From 90 ft. to 100 ft., From ... ft. to ... ft.
 GRAVEL PACK INTERVALS: From 15 ft. to 110 ft., From ... ft. to ... ft.

6 GROUT MATERIAL: 1 Neat cement (circled) 2 Cement grout 3 Bentonite 4 Other ...
 Grout Intervals: From 5 ft. to 15 ft., From ... ft. to ... ft., From ... ft. to ... ft.

What is the nearest source of possible contamination: None Close (circled)
 1 Septic tank 4 Lateral lines 7 Pit privy 10 Livestock pens 14 Abandoned water well
 2 Sewer lines 5 Cess pool 8 Sewage lagoon 11 Fuel storage 15 Oil well/Gas well
 3 Watertight sewer lines 6 Seepage pit 9 Feedyard 12 Fertilizer storage 16 Other (specify below)
 13 Insecticide storage ...

Direction from well? How many feet?

FROM	TO	LITHOLOGIC LOG	FROM	TO	LITHOLOGIC LOG
0	4	Brown Clay			
4	13	Yellow Clay			
13	21	Rock			
21	32	Yellow Clay			
32	37	Rock			
37	44	Brown Clay			
44	47	Rock			
47	50	Brown Clay			
50	62	Rock			
62	70	Brown Clay			
70	90	Rock			
90	95	Shale			
95	106	Rock			
106	110	Blac Shale			

7 CONTRACTOR'S OR LANDOWNER'S CERTIFICATION: This water well was (1) constructed, (2) reconstructed, or (3) plugged under my jurisdiction and was completed on (mo/day/year) 10/15/85 and this record is true to the best of my knowledge and belief. Kansas Water Well Contractor's License No. 451 This Water Well Record was completed on (mo/day/yr) 11/10/85 under the business name of Halldeman Well Drilling by (signature) Craig Halldeman

INSTRUCTIONS: Use typewriter or ball point pen, PLEASE PRESS FIRMLY and PRINT clearly. Please fill in blanks, underline or circle the correct answers. Send top three copies to Kansas Department of Health and Environment, Division of Environment, Environmental Geology Section, Topeka, KS 66620. Send one to WATER WELL OWNER and retain one for your records.