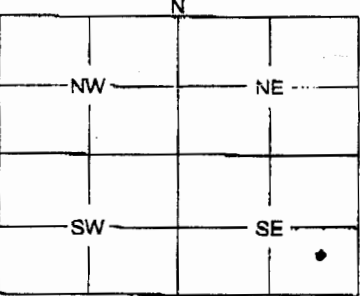


WATER WELL PLUGGING RECORD

Form WWC-5P

KSA 82a-1212

ID NO.

1	LOCATION OF WATER WELL: County: <u>Pawnee</u> Distance and direction from nearest town or city street address of well if located within city? <u>6 mi S 1 1/2 W adjacent on K19 Hwy</u>	Fraction <u>SE 1/4 SW 1/4</u>	Section Number <u>31</u>	Township Number <u>22</u>	Range Number <u>16</u> EW																								
2	WATER WELL OWNER: <u>933 10th Ave</u> RR #, St. Address, Box #: <u>Linda Converse</u> City, State, ZIP Code: _____ Board of Agriculture, Division of Water Resources Application Number: _____																												
3	MARK WELL'S LOCATION WITH AN "X" IN SECTION BOX: <div style="text-align: center;">  </div>																												
4	DEPTH OF WELL <u>77</u> ft. WELL'S STATIC WATER LEVEL <u>44</u> ft. WELL WAS USED AS: <div style="display: flex; justify-content: space-between;"> <div> 1 Domestic 2 Irrigation 3 Feedlot 4 Industrial </div> <div> 5 Public Water Supply 6 Oil Field Water Supply 7 Domestic (Lawn & Garden) 8 Air Conditioning </div> <div> 9 Dewatering 10 Monitoring Well 11 Injection Well 12 Other </div> </div> Was a chemical / bacteriological sample submitted to Department? Yes _____ No <u>X</u> If yes, mo/day/yr sample was submitted _____ Water Well Disinfected: Yes <u>X</u> No _____																												
5	TYPE OF BLANK CASING USED: <div style="display: flex; justify-content: space-between;"> <div> 1 Steel 2 PVC </div> <div> 3 RMP (SR) 4 ABS </div> <div> 5 Wrought 6 Asbestos-Cement </div> <div> 7 Fiberglass 8 Concrete Tile </div> <div> 9 Other (Specify below) </div> </div> Blank casing diameter <u>S</u> in. Was casing pulled? Yes _____ No <u>X</u> If yes, how much _____ Casing height above or below land surface _____ in.																												
6	GROUT PLUG MATERIAL: 1 Neat cement 2 <u>Cement grout</u> 3 Bentonite 4 Other _____ Grout Plug Intervals: From <u>77</u> ft. to <u>72</u> ft. From <u>72</u> ft. to <u>74</u> ft. From _____ to _____ ft. What is the nearest source of possible contamination: <div style="display: flex; justify-content: space-between;"> <div> 1 Septic tank 2 Sewer lines 3 Watertight sewer lines 4 Lateral lines 5 Cess pool </div> <div> 6 Seepage pit 7 Pit privy 8 Sewage lagoon 9 Feedyard 10 Livestock pens </div> <div> 11 Fuel storage 12 Fertilizer storage 13 Insecticide storage 14 Abandoned water well 15 Oil well/Gas well </div> <div> 16 Other (specify below) <u>New water well</u> </div> </div> Direction from well? <u>WEST</u> How many feet? <u>20</u>																												
<table border="1" style="width:100%; border-collapse: collapse;"> <thead> <tr> <th style="width:10%;">FROM</th> <th style="width:10%;">TO</th> <th style="width:80%;">PLUGGING MATERIALS</th> </tr> </thead> <tbody> <tr> <td>77</td> <td>72</td> <td>Bentonite</td> </tr> <tr> <td>72</td> <td>74</td> <td>Quickrete</td> </tr> <tr> <td>74</td> <td>77</td> <td>Backfill with Dist</td> </tr> <tr><td> </td><td> </td><td> </td></tr> <tr><td> </td><td> </td><td> </td></tr> <tr><td> </td><td> </td><td> </td></tr> <tr><td> </td><td> </td><td> </td></tr> </tbody> </table>						FROM	TO	PLUGGING MATERIALS	77	72	Bentonite	72	74	Quickrete	74	77	Backfill with Dist												
FROM	TO	PLUGGING MATERIALS																											
77	72	Bentonite																											
72	74	Quickrete																											
74	77	Backfill with Dist																											
7	CONTRACTOR'S OR LANDOWNER'S CERTIFICATION: This water well was plugged under my jurisdiction and was completed on (mo/day/year) <u>3-17-88</u> and this record is true to the best of my knowledge and belief. Kansas Water Well Contractor's License No. _____ This Water Well Record was completed on (mo/day/year) _____ by (signature) <u>Hale</u> <u>Braniff</u> under the business name of _____																												

INSTRUCTIONS: Use typewriter or ball point pen. Please press firmly and print clearly. Please fill in blanks, underline or circle the correct answers. Send top three copies to Kansas Department of Health and Environment, Bureau of Water, Geology Section, 1000 SW Jackson St., Ste. 420, Topeka, Kansas 66612-1367. Telephone: 785/296-5522. Send one to Water Well Owner and retain one for your records.