

WildBlue Webmail

epsinc@wildblue.net

Paxico Well Forms

From : Jamie Murphy <jmurphy@ppbenv.com>

Wed, Aug 04, 2021 01:15 PM

Subject : Paxico Well Forms

📎 5 attachments

To : epsinc@wildblue.net


Chris,

Attached is the info you will need for the well forms for the Paxico job. The current property owner is Wyldewood Cellars, address is PO Box 45 Mulvane, KS 67110.

Well ID	Static Water Level
MW-1	10.85
MW-2	10.05
MW-3	10.32
MW-4	10.65
MW-5	10.48
MW-6	10.05
MW-7	9.78
MW-8	9.44
MW-9	8.65

Please let me know if you need any additional information or have any questions.

Thanks,

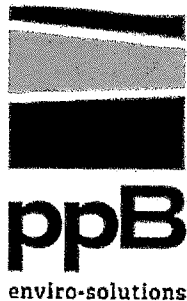**Jamie Murphy, P.G.****Project Geologist**

o: 785.640.9793

a: 112 SW 6th Avenue, Suite 201
Topeka, Kansas 66603w: ppbenv.come: jmurphy@ppbenv.com

— Survey.pdf

395 KB

— Wyldewood Boring Logs Wells Only.pdf

DENNIS L HANDKE

1820 NW 59th Terrace
TOPEKA, KANSAS 66618
785-286-4047 Home

Jamie Murphy
112 SW 6th Street, Suite 201
Topeka, Kansas, 66603

July 29, 2021

RE: Monitor Well Elevation Survey
32633 Grapevine Rd., Paxico, Kansas

Proj. 21-00V
Wyldewood Cellars Winery
U4-099-15179

Bench Mark: Chisled Square on SW corner of concrete sidewalk at SW corner of building.
Elev: 999.65 North 3058.98 West 5201.26 (from SE Cor. Sec.27-11-11E)


✓ MW-1	rim	999.25	North	3066.55	NW1/4,SW1/4,SW1/4,NW1/4
	top pipe	998.84	West	4944.07	Lat= 39.06667 Long = 96.18627
✓ MW-2	rim	998.58	North	2972.26	SW1/4,SW1/4,SW1/4,NW1/4
	top pipe	998.12	West	4962.26	Lat= 39.06641 Long = 96.18633
✓ MW-3	rim	998.82	North	2986.38	SW1/4,SW1/4,SW1/4,NW1/4
	top pipe	998.43	West	5032.12	Lat= 39.06645 Long = 96.18657
✓ MW-4	rim	998.99	North	3094.36	NE1/4,SW1/4,SW1/4,NW1/4
	top pipe	998.45	West	4872.92	Lat= 39.06675 Long = 96.18602
✓ MW-5	rim	998.99	North	3037.33	NW1/4,SW1/4,SW1/4,NW1/4
	top pipe	998.57	West	5041.53	Lat= 39.06659 Long = 96.18661
✓ MW-6	rim	998.58	North	3020.51	NE1/4,SW1/4,SW1/4,NW1/4
	top pipe	998.13	West	4886.64	Lat= 39.06655 Long = 96.18606
✓ MW-7	rim	998.18	North	2858.47	SE1/4,SW1/4,SW1/4,NW1/4
	top pipe	997.63	West	4851.65	Lat= 39.06610 Long = 96.18593
✓ MW-8	rim	997.94	North	2905.11	SW1/4,SW1/4,SW1/4,NW1/4
	top pipe	997.35	West	4966.30	Lat= 39.06623 Long = 96.18634
✓ MW-9	rim	997.38	North	3200.49	NW1/4,SW1/4,SW1/4,NW1/4
	top pipe	996.81	West	5108.40	Lat= 39.06704 Long = 96.18685

Lat & Long derived from McFarland 7.5' quad map. WGS84

Elevation established from NGS BM L344. NAVD 88

If you have any questions, please feel free to call me. Thank you for the opportunity to be of service to you.

Dennis L Handke RLS

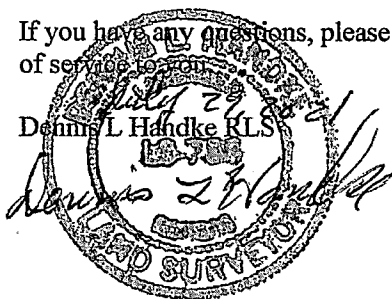


Property Boundary	Current Building	Gas	Agricultural	Other
Monitoring Well	Current Canopy	OH Electric	Commercial	Residential
Soil Boring	Former Product Lines	Septic	Exempt	Utilities
Geotechnical Boring	Former Pump Island	Water	Farm Homesite	Vacant
	Former Tank Basin		Not for Profit	

Notes:
 1) Groundwater flow direction unknown, but inferred towards the southeast based on topography and regional drainage
 2) All known utilities visible during the site visit are shown. Figures will be updated following the utility locate conducted during the LSA.



DESIGNED BY:	CP
DRAWN BY:	CP
CHECKED BY:	JM
APPROVED BY:	CC
DATE:	MAY 2021

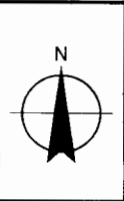

Site Map
Wyldewood Cellars Winery

32633 Grapevine Rd.
Paxico, Kansas
U4-099-15179

FIGURE
2

**Limited Site
Assessment
Work Plan**