

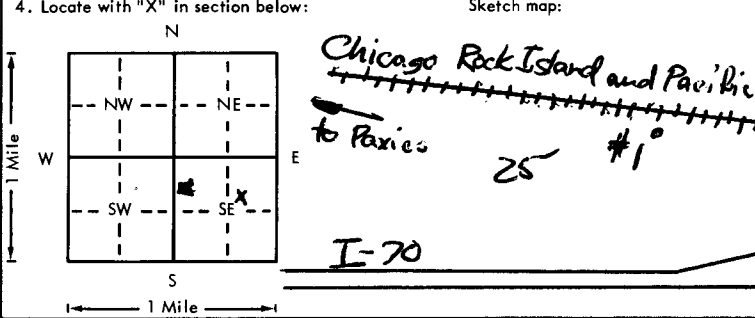
USE TYPEWRITER OR BALL POINT PEN-PRESS FIRMLY, PRINT CLEARLY.

117a

WATER WELL RECORD
KSA 82g-1201-1215

Kansas Department of Health and Environment
Division of Environment
(Water well Contractors)
Topeka, Kansas 66620

JAC

1. Location of well:	County Wabawisee	Fraction SW 1/4 NE 1/4 SE 1/4	Section number 25	Township number T 11 S	Range number R 11 E
2. Distance and direction from nearest town or city: Street address of well location if in city:	1 1/4 mi. East of Paxie, KS.		3. Owner of well: Highway Oil Co. R.R. or street: 1200 First National Bank Tower City, state, zip code: Topeka, KS 66103		
4. Locate with "X" in section below:	Sketch map: 		6. Bore hole dia. 18 in. Completion date 5-8-80 Well depth 56 ft.		
5. Type and color of material		From	To	7. Cable tool ___ Rotary ___ Driven <input checked="" type="checkbox"/> ___ Hollow rod ___ Jetted ___ Bored <input checked="" type="checkbox"/> Reverse rotary	
	Topsail	0	3'	8. Use: ___ Domestic ___ Public supply <input checked="" type="checkbox"/> Industry ___ Irrigation ___ Air conditioning <input checked="" type="checkbox"/> Stock ___ Lawn ___ Oil field water ___ Other	
	Brown Silty Clay	3'	38'	9. Casing: Material Steel Height: Above or below Threaded ___ Welded <input checked="" type="checkbox"/> Surface 24 in. RMP ___ PVC ___ Weight 28.6 lbs./ft. Dia. 8 in. to 56 ft. depth; Wall Thickness: inches or Dia. ___ in. to ___ ft. depth; gage No. 0.322	
	Medium to Coarse gravel w/ tr sand	38'	50'	10. Screen: Manufacturer's name Johnson Stainless Steel Type Wire wound Dia. 8" Slot/gauze 200 Length 7' Set between 43 ft. and 50 ft. Gravel pack? <input checked="" type="checkbox"/> Yes <input type="checkbox"/> No Size range of material 1/2" x 1/4"	
	Shale	50'	56' 6"	11. Static water level: ___ mo./day/yr. 34.3 ft. below land surface Date 5-12-80	
(Use a second sheet if needed)			12. Pumping level below land surfaces: 40.7 ft. after 10 hrs. pumping 100 g.p.m. ___ ft. after ___ hrs. pumping ___ g.p.m. Estimated maximum yield 100 g.p.m.		
			13. Water sample submitted: ___ mo./day/yr. <input checked="" type="checkbox"/> Yes <input type="checkbox"/> No Date 5/13/80		
			14. Well head completion: <input checked="" type="checkbox"/> Pitless adapter 30 inches above grade <input checked="" type="checkbox"/> Well grouted? yes With: ___ Neat cement ___ Bentonite ___ Concrete Depth: From 18 ft. to 20 ft.		
			16. Nearest source of possible contamination: ft. 500 Direction West Type River Well disinfected upon completion? <input checked="" type="checkbox"/> Yes <input type="checkbox"/> No		
			17. Pump: Not installed Manufacturer's name JACH 281 Model number 56' 11XP HP 15 Volts 460 Length of drop pipe 44 ft. capacity 100 g.p.m. Type: <input checked="" type="checkbox"/> Submersible ___ Turbine ___ Jet ___ Reciprocating ___ Centrifugal ___ Other		
18. Elevation: 980	19. Remarks: WELL #1		20. Water well contractor's certification: This well was drilled under my jurisdiction and this report is true to the best of my knowledge and belief. LAYNE - WESTERN CO. INC. Business name License No. ___ Address 1010 W. 39th KCMO 149 Signed Paul B. ... Date 6/1/80 Authorized representative		

T
R
W
E
Q
S
S
W
E
S
E