


WATER WELL RECORD Form WWC-5 KSA 82a-1212

| | | | | |
|---|---|----------------------------|----------------------------------|---------------------------------|
| 1 LOCATION OF WATER WELL: County: <u>Wab.</u> | Fraction <u>S.E. 1/4 N.E. 1/4 S.E. 1/4</u> | Section Number <u>6</u> | Township Number <u>T 11 S</u> | Range Number <u>R 11 E/W</u> |
|---|---|----------------------------|----------------------------------|---------------------------------|

Distance and direction from nearest town or city street address of well if located within city?
3 miles north of Newbury, Ks., 3 miles west and 1/4 mile north.

| | |
|---|--|
| 2 WATER WELL OWNER: <u>Lloyd Banks</u> RR#, St. Address, Box # : <u>21905 Hiway 24 East</u> City, State, ZIP Code : <u>Wamego, Ks. 66547</u> | Board of Agriculture, Division of Water Resources Application Number: <u>N.A. Abandoned</u> |
|---|--|

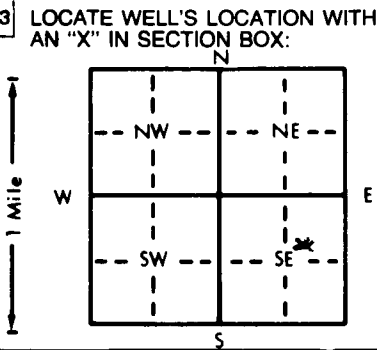

4 DEPTH OF COMPLETED WELL 39 ft. **ELEVATION:** _____

Depth(s) Groundwater Encountered 1 18 ft. 2. _____ ft. 3. _____ ft.

WELL'S STATIC WATER LEVEL 18 ft. below land surface measured on mo/day/yr 1-21-95

Pump test data: Well water was N.A. ft. after _____ hours pumping _____ gpm

Est. Yield N.A. gpm: Well water was _____ ft. after _____ hours pumping _____ gpm

Bore Hole Diameter 36 in. to 39 ft. and _____ in. to _____ ft.

WELL WATER TO BE USED AS:

| | | |
|-----------------------|--------------------|--------------------------|
| 5 Public water supply | 8 Air conditioning | 11 Injection well |
| 1 Domestic | 3 Feedlot | 6 Oil field water supply |
| 2 Irrigation | 4 Industrial | 7 Lawn and garden only |
| | | 10 Monitoring well |

12 Other (Specify below) Windmill

Was a chemical/bacteriological sample submitted to Department? Yes _____ No XX; If yes, mo/day/yr sample was submitted _____

Water Well Disinfected? Yes XX No _____

5 TYPE OF BLANK CASING USED:

| | | | |
|---------|------------|-------------------|-------------------------|
| 1 Steel | 3 RMP (SR) | 6 Asbestos-Cement | 9 Other (specify below) |
| 2 PVC | 4 ABS | 7 Fiberglass | laid stone |

Blank casing diameter below 36 in. to 39 ft., Dia _____ in. to _____ ft.

Casing height above land surface 36 in., weight _____ lbs./ft. Wall thickness or gauge No. _____

TYPE OF SCREEN OR PERFORATION MATERIAL: N.A.

| | | | | |
|---------|--------------------|-----------------|------------|--------------------------|
| 1 Steel | 3 Stainless steel | 5 Fiberglass | 8 RMP (SR) | 11 Other (specify) |
| 2 Brass | 4 Galvanized steel | 6 Concrete tile | 9 ABS | 12 None used (open hole) |

SCREEN OR PERFORATION OPENINGS ARE: N.A.

| | | | | |
|--------------------|---------------|------------------|--------------------|---------------------|
| 1 Continuous slot | 3 Mill slot | 5 Gauzed wrapped | 8 Saw cut | 11 None (open hole) |
| 2 Louvered shutter | 4 Key punched | 6 Wire wrapped | 9 Drilled holes | |
| | | 7 Torch cut | 10 Other (specify) | |

SCREEN-PERFORATED INTERVALS: From N.A. ft. to _____ ft., From _____ ft. to _____ ft.

GRAVEL PACK INTERVALS: From N.A. ft. to _____ ft., From _____ ft. to _____ ft.

6 GROUT MATERIAL: 1 Neat cement 2 Cement grout 3 Bentonite 4 Other _____

Grout Intervals: From 3 ft. to 4 ft., From _____ ft. to _____ ft.

What is the nearest source of possible contamination:

| | | | | |
|--------------------------|-----------------|-----------------|------------------------|-----------------------------|
| 1 Septic tank | 4 Lateral lines | 7 Pit privy | 10 Livestock pens | 14 Abandoned water well |
| 2 Sewer lines | 5 Cess pool | 8 Sewage lagoon | 11 Fuel storage | 15 Oil well/Gas well |
| 3 Watertight sewer lines | 6 Seepage pit | 9 Feedyard | 12 Fertilizer storage | 16 Other (specify below) |
| | | | 13 Insecticide storage | <u>Creek (intermittent)</u> |

Direction from well? 40' north How many feet? 40

| FROM | TO | LITHOLOGIC LOG | FROM | TO | PLUGGING INTERVALS |
|------|----|---------------------------------------|------|----|--------------------|
| 99 | 18 | Chlorinated U.D.1 | | | |
| 18 | 4 | Compacted surface clays and silts | | | |
| 4 | 3 | 3/8 granular bentonite | | | |
| 3 | 0 | Stones removed and well covered over. | | | |
| | | | | | |
| | | | | | |
| | | | | | |
| | | | | | |
| | | | | | |
| | | | | | |

7 CONTRACTOR'S OR LANDOWNER'S CERTIFICATION: This water well was (1) constructed, (2) reconstructed, or (3) plugged under my jurisdiction and was completed on (mo/day/year) 1-21-95 and this record is true to the best of my knowledge and belief. Kansas Water Well Contractor's License No. 323 This Water Well Record was completed on (mo/day/yr) 1-30-95 under the business name of Hoobler Drilling Co. by (signature) [Signature]

INSTRUCTIONS: Use typewriter or ball point pen. PLEASE PRESS FIRMLY and PRINT clearly. Please fill in blanks, underline or circle the correct answers. Send top three copies to Kansas Department of Health and Environment, Bureau of Water, Topeka, Kansas 66620-0001. Telephone: 913-296-5545. Send one to WATER WELL OWNER and retain one for your records.

OFFICE USE ONLY

E/W SEC.