

County: Shawnee Fraction NE NE SE NE Sec. 1 T 11 S R 12 EW

CORRECTION(S) TO WATER WELL COMPLETION RECORD (WWC-5)

(to rectify lacking or incorrect information)

Owner: John C. Adams

Location was listed as:

Location changed to:

Section-Township-Range: None Given.

1-11 S-12 E

Fraction (1/4 1/4 1/4): _____

NE NE SE NE

Other changes: Initial statements: Wabaunsee County

Changed to: Shawnee County

Comments: _____

Verification method: Latitude & longitude, KGS' "LEO" conversion tool,
Shawnee County online parcel search, and mapping tool
& aerial photos on KGS website. initials: DPL date: 5/13/2015

Submitted by: Kansas Geological Survey, Data Resources Library, 1930 Constant Ave., Lawrence, KS 66047-3726
to: Kansas Dept of Health & Environment, Bureau of Water, 1000 SW Jackson, Suite 420, Topeka, KS 66612-1367.

WATER WELL RECORD

Form WWC-5


Division of Water Resources App. No.

1 LOCATION OF WATER WELL: County: <u>Waubaussee</u>	Fraction $\frac{1}{4}$ $\frac{1}{4}$ $\frac{1}{4}$ $\frac{1}{4}$	Section Number	Township No. T S	Range Number R <input type="checkbox"/> E <input type="checkbox"/> W
---	---	----------------	-----------------------	---

Street/Rural Address of Well Location; if unknown, distance & direction from nearest town or intersection: If at owner's address, check here .

Global Positioning System (GPS) information:
 Latitude: 39.12592..... (in decimal degrees)
 Longitude: 096.02083..... (in decimal degrees)
 Elevation: 919.....
 Datum: WGS 84, NAD 83, NAD 27
 Collection Method:
 GPS unit (Make/Model: Garmin 60CSX).....
 Digital Map/Photo, Topographic Map, Land Survey
 Est. Accuracy: <3 m, 3-5 m, 5-15 m, >15 m

2 WATER WELL OWNER: John C Adams
 RR#, Street Address, Box #: 32030 5 Rd
 City, State, ZIP Code : Plains, Kansas

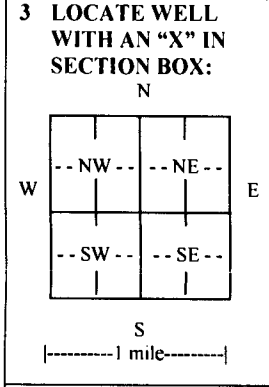

4 DEPTH OF COMPLETED WELL 40'..... ft.

Depth(s) Groundwater Encountered (1) 14..... ft. (2)..... ft. (3)..... ft.

WELL'S STATIC WATER LEVEL 14..... ft. below land surface measured on mo/day/yr. 12/18/2013.....

Pump test data: Well water was 30'..... ft. after 6..... hours pumping. 600'..... gpm

EST. YIELD..... gpm. Well water was..... ft. after..... hours pumping..... gpm

Bore Hole Diameter 36..... in. to 40'..... ft., and..... in. to..... ft.

WELL WATER TO BE USED AS: Public water supply Geothermal Injection well
 Domestic Feedlot Oil field water supply Dewatering Other (Specify below)
 Irrigation Industrial Domestic-lawn & garden Monitoring well

Was a chemical/bacteriological sample submitted to Department? Yes No
 If yes, mo/day/yr sample was submitted.....

Water well disinfected? Yes No

5 TYPE OF CASING USED: Steel PVC Other

CASING JOINTS: Glued Clamped Welded Threaded

Casing diameter 16..... in. to 40'..... ft., Diameter..... in. to..... ft., Diameter..... in. to..... ft.

Casing height above land surface 12..... in., Weight..... lbs./ft., Wall thickness or gauge No. SDR26.....

TYPE OF SCREEN OR PERFORATION MATERIAL:
 Steel Stainless Steel PVC Other (Specify)

Brass Galvanized Steel None used (open hole)

SCREEN OR PERFORATION OPENINGS ARE:
 Continuous slot Mill slot Gauze wrapped Torch cut Drilled holes None (open hole)
 Louvered shutter Key punched Wire wrapped Saw cut Other (specify)

SCREEN-PERFORATED INTERVALS: From 30'..... ft. to 40'..... ft., From..... ft. to..... ft.
 From..... ft. to..... ft., From..... ft. to..... ft.

GRAVEL PACK INTERVALS: From 20'..... ft. to 40'..... ft., From..... ft. to..... ft.
 From..... ft. to..... ft., From..... ft. to..... ft.

6 GROUT MATERIAL: Neat cement Cement grout Bentonite Other

Grout Intervals: From 0'..... ft. to 20'..... ft., From..... ft. to..... ft., From..... ft. to..... ft.

What is the nearest source of possible contamination:
 Septic tank Lateral lines Pit privy Livestock pens Insecticide storage Other (specify below)
 Sewer lines Cesspool Sewage lagoon Fuel storage Abandoned water well
 Watertight sewer lines Seepage pit Feedyard Fertilizer storage Oil well/gas well none.....

Direction from well..... Distance from well.....

FROM	TO	LITHOLOGIC LOG	FROM	TO	LITHO. LOG (cont.) or PLUGGING INTERVALS
0'	5'	Top Soil and Fine Sand			
5'	10'	Fine Sand			
10'	15'	Fine Sand			
15'	20'	Fine Sand			
20'	25'	Fine Sand - Medium Sand			
25'	30'	Fine Sand - Medium Sand			
30'	35'	Fine Sand - Medium Sand			
35'	40'	Medium Sand and Shale			

7 CONTRACTOR'S OR LANDOWNER'S CERTIFICATION: This water well was constructed, reconstructed, or plugged under my jurisdiction and was completed on (mo/day/year) 12/18/2013..... and this record is true to the best of my knowledge and belief. Kansas Water Well Contractor's License No. 631..... This Water Well Record was completed on (mo/day/year) 04/21/2014..... under the business name of Alexander Pump & Services, Inc...... by (signature) Jerry Alexander

INSTRUCTIONS: Use typewriter or ball point pen. PLEASE PRESS FIRMLY and PRINT clearly. Please fill in blanks and check the correct answers. Send one copy to Kansas Department of Health and Environment, Bureau of Water, Geology Section, 1000 SW Jackson St., Suite 420, Topeka, Kansas 66612-1367. Telephone 785-296-5524. Send one copy to WATER WELL OWNER and retain one for your records. Include fee of \$5.00 for each constructed well. Visit us at <http://www.kdheks.gov/waterwell/index.html>