

13

Vjd R

USE TYPEWRITER OR BALL POINT PEN-PRESS FIRMLY, PRINT CLEARLY.

T R EW sec 1/4 1/4 1/4 No.

WATER WELL RECORD KSA 82a-1201-1215 AAA

Kansas State Dept. Of Health (Water Well Contractors) Farbes-Bldg. 740 Topeka, Kansas 66620

NE NENE

1 Location of well: County WABAUNSEE NEWBURY Township name NENE Fraction NW 1/4 Section number 29 Town number 115 Range number 12 E

Distance and direction from nearest town or city: 4 mi. WEST Street address of well location if in city: MAPLE HILL

3 Owner of well: ART KOEHLER Address: MAPLE HILL, KANS.

4 Well depth: 52 ft. Date of completion 9/3/75 Well diameter 6 in.

5 Cable tool Rotary Driven Dug Hollow rod Jetted Bored Reverse rotary

6 Use: Domestic Public supply Industry Irrigation Air conditioning Commercial Test well

7 Casing: Material PVC Height: above/below Surface 20 in. Threading Welded Surface 233 lbs./ft. Diam. 5 in. to 52 ft. depth Drive shoe? Yes No

8 Screen: Manufacturer Premco Type PVC Dia. 5" Slot/gauge .080 Length 9' Set between 38 ft. and 47 ft. Fittings: Gravel pack Yes No Size range of material 1/2"

9 Static water level: NO MEASUREMENT ft. below land surface Date N.A.

10 Pumping level below land surfaces: _____ ft. after _____ hrs. pumping _____ g.p.m. Estimated maximum yield 20 g.p.m.

11 Water sample submitted: Yes No Date _____

12 Well head completion: N.A. Pitless adapter 24 Inches above grade

13 Well grouted? Yes No Neat cement Bentonite _____ Depth: From 0 ft. to 10 ft.

14 Nearest source of possible contamination: ft. 100 Direction NW Type Septic Well disinfected upon completion? Yes No

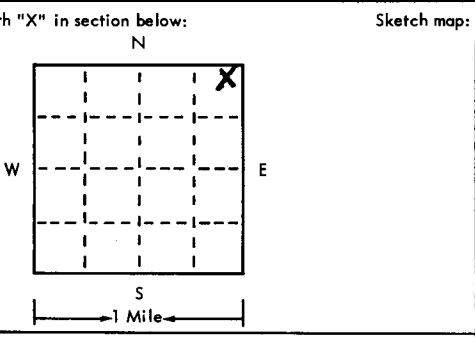
15 Pump: Not installed Manufacturer's name _____ Model number _____ HP _____ Volts _____ Length of drop pipe _____ ft. capacity _____ g.m.p. Type: Submersible Turbine Jet Reciprocating Centrifugal Other

16 Remarks: elevation 960' Topography: Hill Slope Upland Valley

17 Water well contractor's certification: This well was drilled under my jurisdiction and this report is true to the best of my knowledge and belief. Strader Drilling Co. Inc #182 Business name License No. Address 1174 N. Hwy Norton KS Signed Del Loren Date 9-8-75 Authorized representative

2 Type and color of material

Type and color of material	From	To
Top Soil	0	3
Yellow Clay	3	23
LARGE Gravel	23	30
YELLOW Clay	30	38
Big Gravel	38	45
Grey clay	45	47
Blues shale	47	52

Sketch map: 

Forward the white, blue and pink copies to the Kansas State Dept. Of Health.

Form WWC-5

BR = 913

∇
||
||

NENE NE