


1 LOCATION OF WATER WELL: County: Shawnee Fraction S.W. 1/4 N.W. 1/4 S.W. 1/4 Section Number 3 Township Number T 11 S Range Number R 13 E/W

Distance and direction from nearest town or city street address of well if located within city?  
West Of Rossville on U.S. 24 to Capper Rd. south to corner of Capper and N.W. 42nd, 1000' south.

2 WATER WELL OWNER: William Hesse  
636 Griswold  
RR#, St. Address, Box #: Rossville, Ks. 66533  
City, State, ZIP Code: Board of Agriculture, Division of Water Resources  
Application Number: 41,840

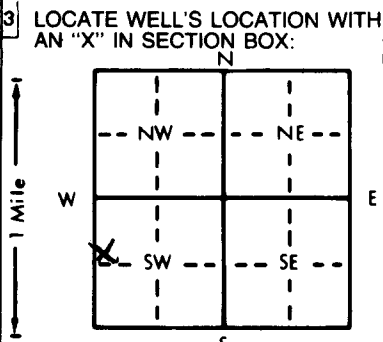

4 DEPTH OF COMPLETED WELL: 46 ft. ELEVATION:  
Depth(s) Groundwater Encountered 1. 17 ft. 2. ft. 3. ft.  
WELL'S STATIC WATER LEVEL 17 ft. below land surface measured on mo/day/yr 6-19-95  
Pump test data: Well water was 32 ft. after 1 hours pumping 500 gpm  
Est. Yield 750 gpm: Well water was 39 ft. after 1 hours pumping 750 gpm  
Bore Hole Diameter 32 in. to 46 ft., and in. to ft.  
WELL WATER TO BE USED AS:  
1 Domestic 3 Feedlot 6 Oil field water supply 9 Dewatering 12 Other (Specify below)  
2 Irrigation 4 Industrial 7 Lawn and garden only 10 Monitoring well  
Was a chemical/bacteriological sample submitted to Department? Yes No XXX; If yes, mo/day/yr sample was submitted Water Well Disinfected? Yes XX No

5 TYPE OF BLANK CASING USED:  
1 Steel 3 RMP (SR) 5 Wrought iron 8 Concrete tile CASING JOINTS: Glued XX Clamped XX  
2 PVC 4 ABS 6 Asbestos-Cement 9 Other (specify below) Welded  
7 Fiberglass Threaded  
Blank casing diameter 16 in. to 26 ft., Dia in. to ft., Dia in. to ft.  
Casing height above land surface 12 in., weight lbs./ft. Wall thickness or gauge No. 50  
TYPE OF SCREEN OR PERFORATION MATERIAL:  
1 Steel 3 Stainless steel 5 Fiberglass 8 RMP (SR) 10 Asbestos-cement 11 Other (specify)  
2 Brass 4 Galvanized steel 6 Concrete tile 9 ABS 12 None used (open hole)  
SCREEN OR PERFORATION OPENINGS ARE:  
1 Continuous slot 3 Mill slot 5 Gauzed wrapped 8 Saw cut 11 None (open hole)  
2 Louvered shutter 4 Key punched 6 Wire wrapped 9 Drilled holes 10 Other (specify)  
7 Torch cut  
SCREEN-PERFORATED INTERVALS: From 26 ft. to 46 ft., From ft. to ft.  
GRAVEL PACK INTERVALS: From 17 ft. to 46 ft., From ft. to ft.

6 GROUT MATERIAL: 1 Neat cement 2 Cement grout 3 Bentonite 4 Other  
Grout Intervals: From 0 ft. to 17 ft., From ft. to ft., From ft. to ft.  
What is the nearest source of possible contamination:  
1 Septic tank 4 Lateral lines 7 Pit privy 10 Livestock pens 14 Abandoned water well  
2 Sewer lines 5 Cess pool 8 Sewage lagoon 11 Fuel storage 15 Oil well/Gas well  
3 Watertight sewer lines 6 Seepage pit 9 Feedyard 12 Fertilizer storage 16 Other (specify below) none  
13 Insecticide storage  
Direction from well? How many feet?

FROM	TO	LITHOLOGIC LOG	FROM	TO	PLUGGING INTERVALS
0	3	Black top soil			
3	13	Brown silty clay			
13	26	Small brown sand			
26	29	Medium grey gravel			
29	37	Medium-large grey gravel and grey clay			
37	46	Medium-large green gravel			
46		Limestone, stopped			

7 CONTRACTOR'S OR LANDOWNER'S CERTIFICATION: This water well was (1) constructed, (2) reconstructed, or (3) plugged under my jurisdiction and was completed on (mo/day/year) 6-19-95 and this record is true to the best of my knowledge and belief. Kansas Water Well Contractor's License No. 323 This Water Well Record was completed on (mo/day/yr) 7-5-95 under the business name of Hoobler Drilling Co. by (signature) [Signature]

INSTRUCTIONS: Use typewriter or ball point pen. PLEASE PRESS FIRMLY and PRINT clearly. Please fill in blanks, underline or circle the correct answers. Send top three copies to Kansas Department of Health and Environment, Bureau of Water, Topeka, Kansas 66620-0001. Telephone: 913-296-5545. Send one to WATER WELL OWNER and retain one for your records.

OFFICE USE ONLY  
T  
R  
EW  
SEC.  
1/4  
1/4  
1/4