

192

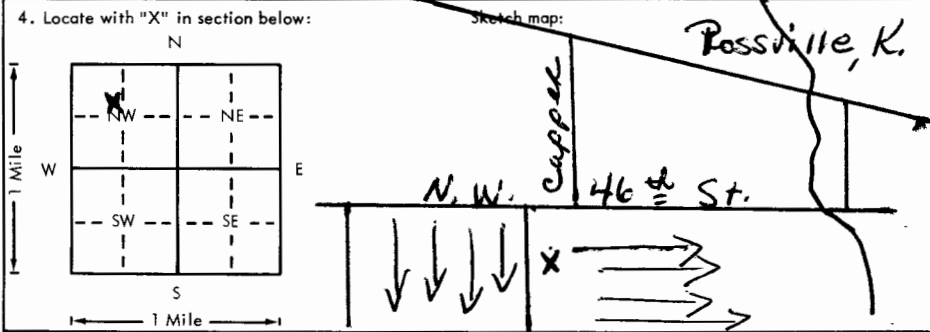
41

USE TYPEWRITER OR BALL POINT PEN-PRESS FIRMLY, PRINT CLEARLY.

WATER WELL RECORD
KSA 82a-1201-1215

Kansas Department of Health and Environment-Division of Environment
(Water well Contractors)
Topeka, Kansas 66620

SE NW NW

1. Location of well: County Shawnee		Fraction Near Ctr. of NW 1/4 NW 1/4	Section number 3	Township number T 11 (S)	Range number R 13 (E)
2. Distance and direction from nearest town or city: 1/2 mi. South of Rossville, Ks. to N.W. 46th St. & 3/4 mi. W. Street address of well location if in city:			3. Owner of well: Lucile Harvey R.N. or street: Box 343 City, state, zip code: Baldwin, Kansas 66006		
4. Locate with "X" in section below: 			6. Bore hole dia. 30 in. Completion date 3-29-77 Well depth 52 ft.		
5. Type and color of material			7. <input type="checkbox"/> Cable tool <input type="checkbox"/> Rotary <input type="checkbox"/> Driven <input type="checkbox"/> Dug <input type="checkbox"/> Hollow rod <input type="checkbox"/> Jetted <input type="checkbox"/> Bored <input checked="" type="checkbox"/> Reverse rotary		
Hard black gumbo			8. Use: <input type="checkbox"/> Domestic <input type="checkbox"/> Public supply <input type="checkbox"/> Industry <input checked="" type="checkbox"/> Irrigation <input type="checkbox"/> Air conditioning <input type="checkbox"/> Stock <input type="checkbox"/> Lawn <input type="checkbox"/> Oil field water <input type="checkbox"/> Other		
Light brown silty sand			9. Casing: Material Trans Height (Above or below Threaded <input type="checkbox"/> Welded <input type="checkbox"/> Surface 12 in. RMP <input type="checkbox"/> PVC <input type="checkbox"/> Weight <input type="checkbox"/> lbs./ft. Dia. 16 n. to 26 ft. depth Wall Thickness: inches or Dia. <input type="checkbox"/> in. to <input type="checkbox"/> ft. depth gage No. 75 "		
Small brown gravel			10. Screen: Manufacturer's name Johnson Well Co. Type Transite Dia. 16" (Slot) gauge 1/8x8 Length 26' Set between 26 ft. and 52 ft. ft. and <input type="checkbox"/> ft. Gravel pack? yes Size range of material 5/8		
Med. to large brown gravel			11. Static water level: <input type="checkbox"/> mo./day/yr. 23 1/2 ft. below land surface Date 3-29-77		
Fine green sand			12. Pumping level below land surfaces: 34 ft. after 1 hrs. pumping 600 g.p.m. 40 ft. after 3 hrs. pumping 700 g.p.m. Estimated maximum yield 700 g.p.m.		
Med. green gravel			13. Water sample submitted: <input type="checkbox"/> mo./day/yr. <input type="checkbox"/> Yes <input checked="" type="checkbox"/> No Date <input type="checkbox"/>		
Fine green sand			14. Well head completion: <input type="checkbox"/> Pitless adapter <input type="checkbox"/> Inches above grade		
Med. to large green gravel			15. Well grouted? yes With: <input type="checkbox"/> Neat cement <input type="checkbox"/> Bentonite <input checked="" type="checkbox"/> Concrete Depth: From 0 ft. to 10 ft.		
Fine gray sand			16. Nearest source of possible contamination: ft. 1800 Direction NE Type creek Well disinfected upon completion? <input type="checkbox"/> Yes <input checked="" type="checkbox"/> No		
Med. gray gravel & clay			17. Pump: <input checked="" type="checkbox"/> Not installed Manufacturer's name <input type="checkbox"/> Model number <input type="checkbox"/> HP <input type="checkbox"/> Volts <input type="checkbox"/> Length of drop pipe <input type="checkbox"/> ft. capacity <input type="checkbox"/> g.p.m. Type: <input type="checkbox"/> Submersible <input type="checkbox"/> Turbine <input type="checkbox"/> Jet <input type="checkbox"/> Reciprocating <input type="checkbox"/> Centrifugal <input type="checkbox"/> Other		
Med. to large gray gravel			20. Water well contractor's certification: This well was drilled under my jurisdiction and this report is true to the best of my knowledge and belief. Hoobler Drilling Co. 323 Business name License No. Address St. Marys, Ks, 66536 Signed Don Hoobler Date 4-4-77 Authorized representative		
Med. to large gray gravel & hard gray clay					
Stopped-green shale.					
18. Elevation: 926 ft			19. Remarks: We do not install pumps.		
Topography: <input type="checkbox"/> Hill <input type="checkbox"/> Slope <input type="checkbox"/> Upland <input checked="" type="checkbox"/> Valley					

Forward the white, blue and pink copies to the Department of Health and Environment

Form WWC-5

11-130-3 SE NW NW 1/4 1/4