

USE TYPEWRITER OR BALL
POINT PEN-PRESS FIRMLY,
PRINT CLEARLY.

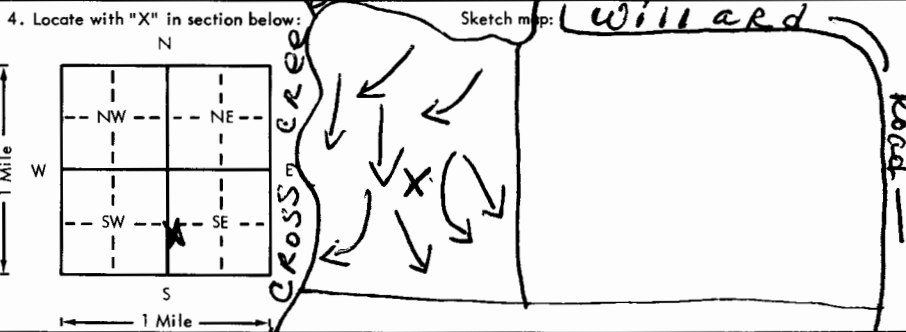
WATER WELL RECORD
KSA 82a-1201-1215

Kansas Department of Health and
Environment-Division of Environment
(Water well Contractors)
Topeka, Kansas 66620

Sent 3-24-77

NE SE SW CDA

Location

1. Location of well:	County Shawnee	Fraction NW 1/4 SE 1/4 SW 1/4	Section number 3	Township number T 40S 11 S	Range number R 13E 9W
2. Distance and direction from nearest town or city: 3 1/2 mi. South & 5/8 mi. West of Rossville, KS. on Willard Rd.			3. Owner of well: Thorton McClain R.R. or street: 603 Main St. City, state, zip code: Rossville, KS. 66533		
4. Locate with "X" in section below: 			6. Bore hole dia. 30 in. Completion date 12-18-76 Well depth 59 ft.		
5. Type and color of material			7. <input type="checkbox"/> Cable tool <input type="checkbox"/> Rotary <input type="checkbox"/> Driven <input type="checkbox"/> Dug <input type="checkbox"/> Hollow rod <input type="checkbox"/> Jetted <input checked="" type="checkbox"/> Bored <input type="checkbox"/> Reverse rotary		
			8. Use: <input checked="" type="checkbox"/> Domestic <input type="checkbox"/> Public supply <input type="checkbox"/> Industry <input checked="" type="checkbox"/> Irrigation <input type="checkbox"/> Air conditioning <input type="checkbox"/> Stock <input type="checkbox"/> Lawn <input type="checkbox"/> Oil field water <input type="checkbox"/> Other		
			9. Casing: Material Trans Height: (Above or below) Threaded <input type="checkbox"/> Welded <input type="checkbox"/> Surface <input type="checkbox"/> in. RMP <input type="checkbox"/> PVC <input type="checkbox"/> Weight <input type="checkbox"/> lbs./ft. Dia. 16 in. to 33 ft. depth Wall Thickness: inches or Dia. <input type="checkbox"/> in. to <input type="checkbox"/> ft. depth Gage No. 7/8		
			10. Screen: Manufacturer's name Johnson Well Co. Type Transite Dia. 16" (Slot/gauze) 1/8x8 Length 26' Set between 33 ft. and 59 ft. Gravel pack? yes Size range of material 5/8		
			11. Static water level: <input type="checkbox"/> mo./day/yr. 21 ft. below land surface Date 12-18-76		
			12. Pumping level below land surfaces: 31 ft. after 1 hrs. pumping 800 g.p.m. 39 ft. after 3 hrs. pumping 1200 g.p.m. Estimated maximum yield 1500 g.p.m.		
			13. Water sample submitted: <input type="checkbox"/> mo./day/yr. <input type="checkbox"/> Yes <input checked="" type="checkbox"/> No Date <input type="checkbox"/>		
			14. Well head completion: <input type="checkbox"/> Pitless adapter <input type="checkbox"/> Inches above grade		
			15. Well grouted? yes With: <input type="checkbox"/> Neat cement <input type="checkbox"/> Bentonite <input checked="" type="checkbox"/> Concrete Depth: From 0 ft. to 10 ft.		
			16. Nearest source of possible contamination: ft. 1500 Direction NW Type Cross Creek Well disinfected upon completion? <input type="checkbox"/> Yes <input checked="" type="checkbox"/> No		
			17. Pump: <input checked="" type="checkbox"/> Not installed Manufacturer's name <input type="checkbox"/> Model number <input type="checkbox"/> HP <input type="checkbox"/> Volts <input type="checkbox"/> Length of drop pipe <input type="checkbox"/> ft. capacity <input type="checkbox"/> g.p.m. Type: <input type="checkbox"/> Submersible <input type="checkbox"/> Turbine <input type="checkbox"/> Jet <input type="checkbox"/> Reciprocating <input type="checkbox"/> Centrifugal <input type="checkbox"/> Other		
18. Elevation:			20. Water well contractor's certification: This well was drilled under my jurisdiction and this report is true to the best of my knowledge and belief. Hoobler Drilling Co. 323 Business name License No. Address St. Marys, KS. 66536 Signed Don Hoobler Date 3-14-77 Authorized representative		
19. Remarks: 922 We do not install pumps. (from map)					

Topography:
☐ Hill
☐ Slope
☐ Upland
☒ Valley

(Use a second sheet if needed)

Forward the white, blue and pink copies to the Department of Health and Environment

Form WWC-5

BR < 859

▽ = 897