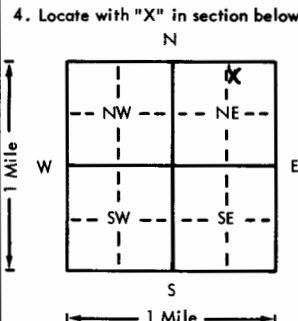


40197

USE TYPEWRITER OR BALL POINT PEN—PRESS FIRMLY, PRINT CLEARLY.

WATER WELL RECORD
KSA 82a-1201-1215

Kansas Department of Health and Environment—Division of Environment
(Water well Contractors)
Topeka, Kansas 66620

1. Location of well: County <u>SHAWNEE</u> Fraction <u>NW 1/4 NE 1/4 NE 1/4</u> Section number <u>5</u> Township number <u>T 11 S R 13</u> Range number <u>Q/W</u>	
2. Distance and direction from nearest town or city: <u>1/2 S - 2 W - 1/2 S</u> Street address of well location if in city: <u>ROSSVILLE</u> 3. Owner of well: <u>ROLLAND PARR</u> R.R. or street: <u>RR #1</u> City, state, zip code: <u>ROSSVILLE, KANSAS 66533</u>	
4. Locate with "X" in section below: Sketch map: 	
5. Type and color of material	
6. Bore hole dia. <u>30</u> in. Completion date <u>4-9-75</u> Well depth <u>51</u> ft.	
7. <input type="checkbox"/> Cable tool <input type="checkbox"/> Rotary <input type="checkbox"/> Driven <input type="checkbox"/> Dug <input type="checkbox"/> Hollow rod <input type="checkbox"/> Jetted <input type="checkbox"/> Bored <input checked="" type="checkbox"/> Reverse rotary	
8. Use: <input type="checkbox"/> Domestic <input type="checkbox"/> Public supply <input type="checkbox"/> Industry <input checked="" type="checkbox"/> Irrigation <input type="checkbox"/> Air conditioning <input type="checkbox"/> Stock <input type="checkbox"/> Lawn <input type="checkbox"/> Oil field water <input type="checkbox"/> Other	
9. Casing: Material <u>AC</u> Height: Above or below <input type="checkbox"/> Threaded <input type="checkbox"/> Welded <input type="checkbox"/> Surface <u>12</u> in. RMP <input type="checkbox"/> PVC <input type="checkbox"/> Weight <u>34</u> lbs./ft. Dia. <u>16</u> in. to <u>51</u> ft. depth; Wall thickness: inches or Dia. <u>in.</u> to <u>ft.</u> depth; gage No. <u>34</u>	
10. Screen: Manufacturer's name <u>JOHNSON CONCRETE</u> Type <u>ASBESTOS CEMENT</u> Dia. <u>16</u> Slot/gauze <u>1/2</u> Length <u>26</u> Set between <u>25</u> ft. and <u>51</u> ft. Gravel pack? <input checked="" type="checkbox"/> YES Size range of material <u>1/8" - 1/4"</u>	
11. Static water level: <u>18</u> ft. below land surface Date <u>4-9-75</u> mo./day/yr.	
12. Pumping level below land surfaces: <u>50</u> ft. after <u>1/2</u> hrs. pumping <u>800</u> g.p.m. Estimated maximum yield <u>850</u> g.p.m.	
13. Water sample submitted: <input checked="" type="checkbox"/> Yes <input type="checkbox"/> No Date _____ mo./day/yr.	
14. Well head completion: <input type="checkbox"/> Pitless adapter <u>12</u> Inches above grade	
15. Well grouted? <u>NOTE REMARKS</u> With: <input type="checkbox"/> Neat cement <input type="checkbox"/> Bentonite <input type="checkbox"/> Concrete Depth: From _____ ft. to _____ ft.	
16. Nearest source of possible contamination: <u>NONE</u> ft. _____ Direction _____ Type _____ Well disinfected upon completion? <input type="checkbox"/> Yes <input type="checkbox"/> No	
17. Pump: <input checked="" type="checkbox"/> Not installed Manufacturer's name _____ Model number _____ HP _____ Volts _____ Length of drop pipe _____ ft. capacity _____ g.p.m. Type: <input type="checkbox"/> Submersible <input type="checkbox"/> Turbine <input type="checkbox"/> Jet <input type="checkbox"/> Reciprocating <input type="checkbox"/> Centrifugal <input type="checkbox"/> Other	
18. Elevation: _____ Topography: <input type="checkbox"/> Hill <input type="checkbox"/> Slope <input type="checkbox"/> Upland <input checked="" type="checkbox"/> Valley	
19. Remarks: <u>Farmers Union Imp. St Marye set pump + grouted well replacement well - no test log</u>	
20. Water well contractor's certification: This well was drilled under my jurisdiction and this report is true to the best of my knowledge and belief. <u>GEO COX & SONS, INC 258</u> Business name License No. Address <u>CLIFTON, KANSAS</u> Signed <u>Francis Cox</u> Date <u>11-20-74</u> Authorized representative	

11-130-5
R
Sec
1/4 1/4 3/4
NORTHLINE

Forward the white, blue and pink copies to the Department of Health and Environment

Form WWC-5