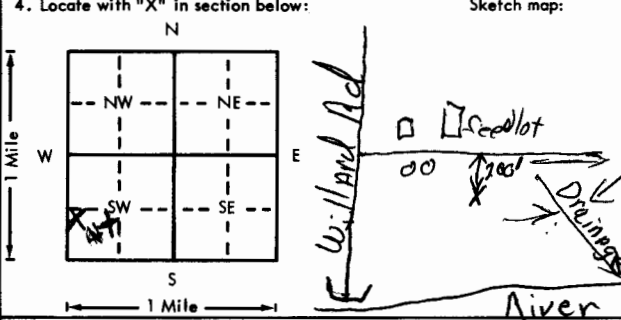


195 ✓ h122

USE TYPEWRITER OR BALL
POINT PEN-PRESS FIRMLY,
PRINT CLEARLY.

WATER WELL RECORD
KSA 82a-1201-1215

Kansas Department of Health and
Environment-Division of Environment
(Water well Contractors)
Topeka, Kansas 66620

1. Location of well:	County Shawnee	Fraction NW 1/4 SW 1/4	Section number 11	Township number T 11 S	Range number R 13 E/W
2. Distance and direction from nearest town or city: 3 1/2 miles S. of Rossville, Ks. on Willard Rd.			3. Owner of well: Walter French, Mrs. Bernice R.R. or street: City, state, zip code: Rossville, Ks. 66533		
4. Locate with "X" in section below: 			6. Bore hole dia. 30 in. Completion date 6-30-76 Well depth 38 ft.		
5. Type and color of material			7. <input type="checkbox"/> Cable tool <input type="checkbox"/> Rotary <input type="checkbox"/> Driven <input type="checkbox"/> Dug <input type="checkbox"/> Hollow rod <input type="checkbox"/> Jetted <input type="checkbox"/> Bored <input checked="" type="checkbox"/> Reverse rotary		
			8. Use: <input type="checkbox"/> Domestic <input type="checkbox"/> Public supply <input type="checkbox"/> Industry <input checked="" type="checkbox"/> Irrigation <input type="checkbox"/> Air conditioning <input type="checkbox"/> Stock <input type="checkbox"/> Lawn <input type="checkbox"/> Oil field water <input type="checkbox"/> Other		
			9. Casing: Material Trans Height: (Above or below) Threaded <input type="checkbox"/> Welded <input type="checkbox"/> Surface <input type="checkbox"/> 12 in. RMP <input type="checkbox"/> PVC <input type="checkbox"/> Weight <input type="checkbox"/> lbs./ft. Dia. 16 in. to 13 ft. depth; Wall Thickness: inches or Dia. <input type="checkbox"/> in. to <input type="checkbox"/> ft. depth; gage No. 7/8		
			10. Screen: Manufacturer's name Johnson Well Co. Type Transite Dia. 16" (Slot) 1/8" Length 26" Set between 38 ft. and 12 ft. Gravel pack? yes Size range of material 5/8		
			11. Static water level: 9 ft. below land surface Date 7-1-76 mo./day/yr.		
			12. Pumping level below land surfaces: 27 ft. after 1 hrs. pumping 1000 g.p.m. 29 ft. after 2 hrs. pumping 1200 g.p.m. Estimated maximum yield 1500 g.p.m.		
			13. Water sample submitted: X Yes <input type="checkbox"/> No Date 7-1-76 mo./day/yr.		
			14. Well head completion: <input type="checkbox"/> Pitless adapter <input type="checkbox"/> Inches above grade		
			15. Well grouted? yes With: <input type="checkbox"/> Neat cement <input type="checkbox"/> Bentonite <input checked="" type="checkbox"/> Concrete Depth: From 0 ft. to 10 ft.		
			16. Nearest source of possible contamination: ft. 400 Direction north Type feedlot Well disinfected upon completion? <input type="checkbox"/> Yes <input checked="" type="checkbox"/> No		
			17. Pump: <input checked="" type="checkbox"/> Not installed Manufacturer's name _____ Model number _____ HP _____ Volts _____ Length of drop pipe _____ ft. capacity _____ g.p.m. Type: <input type="checkbox"/> Submersible <input type="checkbox"/> Turbine <input type="checkbox"/> Jet <input type="checkbox"/> Reciprocating <input type="checkbox"/> Centrifugal <input type="checkbox"/> Other		
18. Elevation: 912 Rm Topography: <input type="checkbox"/> Hill <input type="checkbox"/> Slope <input checked="" type="checkbox"/> Upland <input type="checkbox"/> Valley			19. Remarks: We do not install pumps.		
			20. Water well contractor's certification: This well was drilled under my jurisdiction and this report is true to the best of my knowledge and belief. Noobler Drilling Co. 323 Business name License No. Address St. Marys, Ks. 66536 Signed Alan Noobler Date 6-29-76 Authorized representative		

Forward the white, blue and pink copies to the Department of Health and Environment

Form WWC-5