

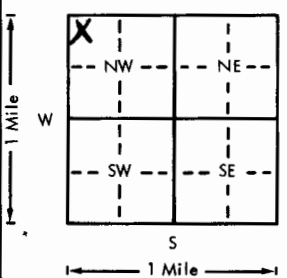
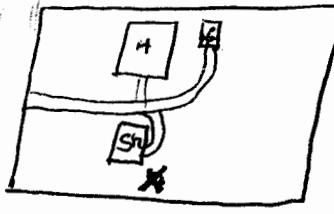
197

USE TYPEWRITER OR BALL POINT PEN-PRESS FIRMLY, PRINT CLEARLY.

WATER WELL RECORD
KSA 82a-1201-1215

Kansas Department of Health and Environment
Division of Environment
(Water well Contractors)
Topeka, Kansas 66620

030

1. Location of well:		County SHAWNEE	Fraction NW 1/4 NW 1/4 NW 1/4	Section number 12	Township number T 11, S R 13 E/W	Range number
2. Distance and direction from nearest town or city: 3 MIL.			3. Owner of well: MR VINCENT MARTINEK			
Street address of well location if in city: RT ROSSVILLE			R.R. or street: ROSSVILLE KAN 66533			
4. Locate with "X" in section below:			Sketch map:		6. Bore hole dia. 8 in. Completion date 4/24/79 Well depth 42 ft.	
				7. Cable tool <input type="checkbox"/> Rotary <input type="checkbox"/> Driven <input type="checkbox"/> Dug <input type="checkbox"/> <input type="checkbox"/> Hollow rod <input type="checkbox"/> Jetted <input checked="" type="checkbox"/> Bored <input type="checkbox"/> Reverse rotary		
5. Type and color of material			From	To	8. Use: <input checked="" type="checkbox"/> Domestic <input type="checkbox"/> Public supply <input type="checkbox"/> Industry <input type="checkbox"/> Irrigation <input type="checkbox"/> Air conditioning <input type="checkbox"/> Stock <input type="checkbox"/> Lawn <input type="checkbox"/> Oil field water <input type="checkbox"/> Other	
Top Soil			1'	2'	9. Casing: Material PLS Height: Above or below Threaded <input type="checkbox"/> Welded <input type="checkbox"/> Surface 12 in. RMP <input checked="" type="checkbox"/> PVC <input type="checkbox"/> Weight _____ lbs./ft. Dia. 5 in. to 42 ft. depth Wall Thickness: inches or Dia. _____ in. to _____ ft. depth gage No. 200	
SANDY LOAM			2	10	10. Screen: Manufacturer's name SUN FLOWER Type SLOT Dia. 5" Slot/gauze 1/4" Length 5' Set between BOTTOM ft. and 37+42 ft. 37 ft. and 42 ft. Gravel pack? <input checked="" type="checkbox"/> Size range of material GRAVEL	
CLAY			10	12	11. Static water level: _____ mo./day/yr. 25 ft. below land surface Date 4/26/79	
SAND (FINE)			12	18	12. Pumping level below land surfaces: 25 ft. after 1 hrs. pumping 14 g.p.m. 25 ft. after 1 hrs. pumping 16 g.p.m. Estimated maximum yield 40 g.p.m.	
GRAY MUDD			18	24	13. Water sample submitted: _____ mo./day/yr. Yes <input type="checkbox"/> No <input checked="" type="checkbox"/> Date _____	
SAND (FINE)			24	36	14. Well head completion: <input checked="" type="checkbox"/> Pitless adapter 12 Inches above grade	
SAND + GRAVEL			36	42	15. Well grouted? <input checked="" type="checkbox"/> With: <input checked="" type="checkbox"/> Neat cement <input type="checkbox"/> Bentonite <input type="checkbox"/> Concrete Depth: From 4 ft. to 15 ft.	
(Use a second sheet if needed)					16. Nearest source of possible contamination: ft. 150' Direction N Type CEPTIC Well disinfected upon completion? <input checked="" type="checkbox"/> Yes <input type="checkbox"/> No	
18. Elevation: 925Rm			19. Remarks:		17. Pump: Not installed Manufacturer's name GOULD Model number 2EH HP 1/2 Volts 115 Length of drop pipe 39 ft. capacity 10 g.p.m. Type: <input checked="" type="checkbox"/> Submersible <input type="checkbox"/> Turbine <input type="checkbox"/> Jet <input type="checkbox"/> Reciprocating <input type="checkbox"/> Centrifugal <input type="checkbox"/> Other	
Topography: <input type="checkbox"/> Hill <input type="checkbox"/> Slope <input type="checkbox"/> Upland <input type="checkbox"/> Valley					20. Water well contractor's certification: This well was drilled under my jurisdiction and this report is true to the best of my knowledge and belief. H.L. PETTIT 333 Business name _____ License No. _____ Address 905 N. MICHIGAN Signed H.L. Pettit Date 4/27/79 Authorized representative	

Forward the white, blue and pink copies to the Department of Health and Environment

Form WWC-5

T
R
S
1/4
1/4
1/4
1/4