


1 LOCATION OF WATER WELL: Fraction SW 1/4 NE 1/4 SW 1/4 Section Number 24 Township Number T 11 S Range Number R 13 **(EW)**

Distance and direction from nearest town or city street address of well if located within city? 1 E 15 of Willard

2 WATER WELL OWNER: Richard J. Dieter II
 RR#, St. Address, Box # : 1444 NW Crawford Rd Board of Agriculture, Division of Water Resources
 City, State, ZIP Code : Topeka, KS 66615 Application Number:

3 LOCATE WELL'S LOCATION WITH AN "X" IN SECTION BOX:

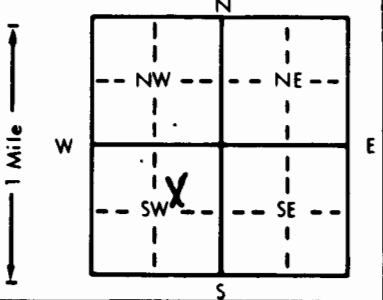

4 DEPTH OF COMPLETED WELL: 50 ft. ELEVATION: _____
 Depth(s) Groundwater Encountered 1 19' ft. 2. _____ ft. 3. _____ ft.
 WELL'S STATIC WATER LEVEL 10' ft. below land surface measured on mo/day/yr 4-28-88
 Pump test data: Well water was _____ ft. after _____ hours pumping _____ gpm
 Est. Yield 8 gpm: Well water was _____ ft. after _____ hours pumping _____ gpm
 Bore Hole Diameter 10" in. to _____ ft., and _____ in. to _____ ft.
 WELL WATER TO BE USED AS:
 5 Public water supply 8 Air conditioning 11 Injection well
 1 Domestic 3 Feedlot 6 Oil field water supply 9 Dewatering 12 Other (Specify below)
 2 Irrigation 4 Industrial 7 Lawn and garden only 10 Observation well
 Was a chemical/bacteriological sample submitted to Department? Yes _____ No X; If yes, mo/day/yr sample was submitted _____
 Water Well Disinfected? Yes X No _____

5 TYPE OF BLANK CASING USED:
 1 Steel 3 RMP (SR) 5 Wrought iron 8 Concrete tile CASING JOINTS: Glued X Clamped _____
 2 PVC 4 ABS 6 Asbestos-Cement 9 Other (specify below) Welded _____
 7 Fiberglass _____ Threaded _____

Blank casing diameter _____ 5" in. to _____ 0-18 ft., Dia _____ 5" in. to _____ 23-49 ft., Dia _____ in. to _____ ft.
 Casing height above land surface _____ 24" in., weight _____ 2.82 lbs./ft. Wall thickness or gauge No. _____ 258

TYPE OF SCREEN OR PERFORATION MATERIAL:
 1 Steel 3 Stainless steel 5 Fiberglass 7 PVC 10 Asbestos-cement
 2 Brass 4 Galvanized steel 6 Concrete tile 9 ABS 11 Other (specify) _____
 12 None used (open hole)

SCREEN OR PERFORATION OPENINGS ARE:
 1 Continuous slot 3 Mill slot 5 Gauzed wrapped 8 Saw cut 11 None (open hole)
 2 Louvered shutter 4 Key punched 6 Wire wrapped 9 Drilled holes
 7 Torch cut 10 Other (specify) _____

SCREEN-PERFORATED INTERVALS: From _____ 18 _____ ft. to _____ 23 _____ ft., From _____ ft. to _____ ft.
 From _____ 49 _____ ft. to _____ 50 _____ ft., From _____ ft. to _____ ft.
 GRAVEL PACK INTERVALS: From _____ 15 _____ ft. to _____ 50 _____ ft., From _____ ft. to _____ ft.
 From _____ ft. to _____ ft., From _____ ft. to _____ ft.

6 GROUT MATERIAL: 1 Neat cement 2 Cement grout 3 Bentonite 4 Other _____
 Grout Intervals: From _____ 0 _____ ft. to _____ 20 _____ ft., From _____ ft. to _____ ft., From _____ ft. to _____ ft.

What is the nearest source of possible contamination:
 1 Septic tank 4 Lateral lines 7 Pit privy 10 Livestock pens 14 Abandoned water well
 2 Sewer lines 5 Cess pool 8 Sewage lagoon 11 Fuel storage 15 Oil well/Gas well
 3 Watertight sewer lines 6 Seepage pit 9 Feedyard 12 Fertilizer storage 16 Other (specify below)
 13 Insecticide storage _____

Direction from well? E How many feet? 110

FROM	TO	LITHOLOGIC LOG	FROM	TO	LITHOLOGIC LOG
0	3	Top Soil			
3	15	Clay-Brown			
15	18	Fine Sand-Coarse Sand-Med-Gravel			
18	19	Limestone-loose-yellow			
19	29	Shale-Grey			
29	31	Limestone-Grey			
31	50	Shale-grey			

7 CONTRACTOR'S OR LANDOWNER'S CERTIFICATION: This water well was (1) constructed, (2) reconstructed, or (3) plugged under my jurisdiction and was completed on (mo/day/year) _____ 4-28-88 _____ and this record is true to the best of my knowledge and belief. Kansas Water Well Contractor's License No. _____ 182 _____ This Water Well Record was completed on (mo/day/yr) _____ 8-15-88 _____ under the business name of Strader Drilling Co., Inc. by (signature) [Signature]

INSTRUCTIONS: Use typewriter or ball point pen. PLEASE PRESS FIRMLY and PRINT clearly. Please fill in blanks. underline or circle the correct answers. Send top three copies to Kansas Department of Health and Environment, Bureau of Water Protection, Topeka, Kansas 66620-7320, Telephone: 913-862-9360. Send one to WATER WELL OWNER and retain one for your records.