

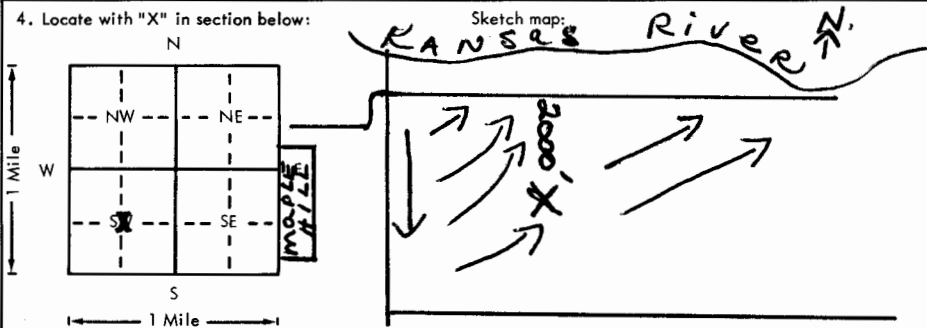
USE TYPEWRITER OR BALL POINT PEN-PRESS FIRMLY, PRINT CLEARLY.

WATER WELL RECORD  
KSA 82a-1201-1215

Kansas Department of Health and Environment-Division of Environment  
(Water well Contractors)  
Topeka, Kansas 66620

*change  
& elev*

*CCA*

X Location of well: <u>Water</u>		County <u>Wabasha</u>	Fraction <u>NE-SW-SW</u> <u>ctr. 1/4 of 1/4 SW</u> 1/4	Section number <u>9</u>	Township number <u>11S</u>	Range number <u>13E</u>	E/W
2 1/4 mi. East of Maple Hill, Ks. 1/4 mi. No. Street address of well location if in city: <u>+ 1/4 mi. E.</u>			3. Owner of well <u>Arthur A. Adams, Jr.</u> R.R. or street: City, state, zip code: <u>Maple Hill, Kansas 66507</u>				
4. Locate with "X" in section below: 			6. Bore hole dia. <u>30</u> in. Completion date <u>3-17-77</u> Well depth <u>43</u> ft.				
5. Type and color of material			From	To	7. <input type="checkbox"/> Cable tool <input type="checkbox"/> Rotary <input type="checkbox"/> Driven <input type="checkbox"/> Dug <input type="checkbox"/> Hollow rod <input type="checkbox"/> Jetted <input type="checkbox"/> Bored <input checked="" type="checkbox"/> Reverse rotary		
Fine silty sand			0	14	8. Use: <input type="checkbox"/> Domestic <input type="checkbox"/> Public supply <input type="checkbox"/> Industry <input checked="" type="checkbox"/> Irrigation <input type="checkbox"/> Air conditioning <input type="checkbox"/> Stock <input type="checkbox"/> Lawn <input type="checkbox"/> Oil field water <input type="checkbox"/> Other		
Fine brown sand			14	17	X Casing: Material <u>Trans.</u> Height (Above) or below Threaded <input type="checkbox"/> Welded <input type="checkbox"/> Surface <u>12</u> in. RMP <input type="checkbox"/> PVC <input type="checkbox"/> Weight _____ lbs./ft. Dia. <u>16</u> in. to <u>23</u> ft. depth; Wall Thickness: inches or Dia. _____ in. to _____ ft. depth; gage No. <u>75</u> "		
Med. brown gravel			17	20	10. Screen: Manufacturer's name <u>Johnson-UOP, Inc.</u> Type <u>Cont. slot</u> Dia. <u>16 PS</u> (Slot) gauze <u>0.100"</u> Length <u>20'</u> Set between <u>23</u> ft. and <u>43</u> ft. _____ ft. and _____ ft. Gravel pack? <u>yes</u> Size range of material <u>1/8-1/4"</u>		
Fine to med. gray gravel			20	25	11. Static water level: _____ mo./day/yr. <u>15</u> ft. below land surface Date <u>3-5-77</u>		
Fine gray sand			25	27	12. Pumping level below land surfaces: <u>23</u> ft. after <u>1</u> hrs. pumping <u>1000</u> g.p.m. <u>26</u> ft. after <u>3</u> hrs. pumping <u>1500</u> g.p.m. Estimated maximum yield <u>1750</u> g.p.m.		
Med. to large gray gravel			27	30	13. Water sample submitted: _____ mo./day/yr. Yes <input type="checkbox"/> No <input checked="" type="checkbox"/> Date _____		
Fine to med. gray gravel			30	34	14. Well head completion: <input type="checkbox"/> Pitless adapter _____ Inches above grade		
Med. gray gravel			34	35	15. Well grouted? <u>yes</u> With: <input type="checkbox"/> Neat cement <input type="checkbox"/> Bentonite <input checked="" type="checkbox"/> Concrete Depth: From <u>0</u> ft. to <u>10</u> ft.		
Med. to large gray gravel			35	43	16. Nearest source of possible contamination: ft. <u>1600</u> Direction <u>north</u> Type <u>river</u> Well disinfected upon completion? Yes <input type="checkbox"/> No <input checked="" type="checkbox"/>		
Gray shale-stopped.			43		17. Pump: <input checked="" type="checkbox"/> Not installed Manufacturer's name _____ Model number _____ HP _____ Volts _____ Length of drop pipe _____ ft. capacity _____ g.p.m. Type: <input type="checkbox"/> Submersible <input type="checkbox"/> Turbine <input type="checkbox"/> Jet <input type="checkbox"/> Reciprocating <input type="checkbox"/> Centrifugal <input type="checkbox"/> Other		
(Use a second sheet if needed)							
18. Elevation: <u>915'</u> Topography: _____ <input type="checkbox"/> Hill <input type="checkbox"/> Slope <input type="checkbox"/> Upland <input checked="" type="checkbox"/> Valley		19. Remarks: <b>Set up for center pivot.</b> <b>We do not install pumps.</b>			20. Water well contractor's certification: This well was drilled under my jurisdiction and this report is true to the best of my knowledge and belief. <b>Hoobler Drilling Co. 323</b> Business name _____ License No. _____ Address <u>St. Marys, Ks. 66536</u> Signed <u>Danfahlu</u> Date <u>4-6-77</u> Authorized representative		

T  
R  
W  
E  
-  
2  
1/4  
1/4  
1/4  
1/4  
1/4  
1/4