

62

draw of elev.

USE TYPEWRITER OR BALL POINT PEN-PRESS FIRMLY, PRINT CLEARLY.


WATER WELL RECORD
KSA 82a-1201-1215

Kansas Department of Health and Environment-Division of Environment
(Water well Contractors)
Topeka, Kansas 66620

X Location of well:	County	Fraction	Section number	Township number	Range number
	Wabaunsee	Near ^{1/4} Ctr. ^{1/4} of SE ^{1/4}	9	T 11S S R	13E E/W

2. Distance and direction from nearest town or city: ~~1 1/2 mi. West of Millard, Ks.~~ ~~1 1/2 mi. South~~ ^{1/4 mi. N.}
Street address of well location if in city: ^{3/4 mi. E. + 1/4 mi. N.}

3. Owner of well: **Arthur A. Adams, Jr.**
R.R. or street:
City, state, zip code: **Maple Hill, Kansas 66507**

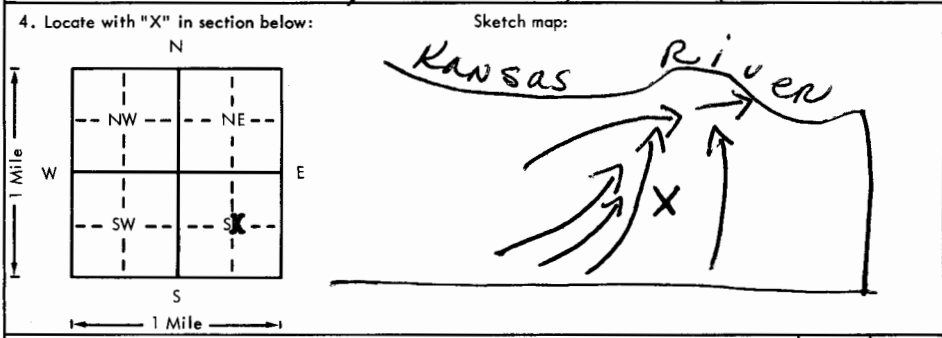

6. Bore hole dia. 30 in. Completion date 3-21-77
Well depth 29 ft.

7. Cable tool Rotary Driven Dug
 Hollow rod Jetted Bored Reverse rotary

8. Use: Domestic Public supply Industry
 Irrigation Air conditioning Stock
 Lawn Oil field water Other

9. Casing: Material Steel Height (Above or below)
Threaded Welded Surface 12 in.
RMP PVC Weight _____ lbs./ft.
Dia. 16 in. to 14 ft. depth Wall Thickness: inches or
Dia. _____ in. to _____ ft. depth gage No. .219 w.t.

5. Type and color of material	From	To
Light brown top soil	0	2
Black gumbo	2	4
Med. brown gravel	4	21
Soft gray clay	21	24
Large gray gravel	24	29
Gray shale-stopped.	29	
(Use a second sheet if needed)		

10. Screen: Manufacturer's name Johnson-UOP, Inc, Steel
Type Cont. slot steel-16 PS
Slot/gauze 0.100" Length 15'
Set between 14 ft. and 29 ft.
_____ ft. and _____ ft.
Gravel pack? yes Size range of material 1/8-1/4"

11. Static water level: _____ mo./day/yr.
13 ft. below land surface Date 3-25-77

12. Pumping level below land surfaces:
25 ft. after 1 hrs. pumping 300 g.p.m.
28 ft. after 3 hrs. pumping 400 g.p.m.
Estimated maximum yield 400 g.p.m.

13. Water sample submitted: _____ mo./day/yr.
Yes No Date _____

14. Well head completion:
 Pitless adapter _____ Inches above grade

15. Well grouted? yes
With: Neat cement Bentonite Concrete
Depth: From 0 ft. to 10 ft.

16. Nearest source of possible contamination:
ft. 200' Direction north Type low area
Well disinfected upon completion? Yes No

17. Pump: Not installed
Manufacturer's name _____
Model number _____ HP _____ Volts _____
Length of drop pipe _____ ft. capacity _____ g.p.m.
Type:
 Submersible Turbine
 Jet Reciprocating
 Centrifugal Other

18. Elevation: 917'
Topography:
 Hill
 Slope
 Upland
 Valley

19. Remarks:
Set up for center pivot
We do not install pumps.

20. Water well contractor's certification:
This well was drilled under my jurisdiction and this report is true to the best of my knowledge and belief.
Hoobler Drilling Co. 323
Business name License No.
Address St. Marys, Ks. 66536
Signed Don Hoobler Date 4-6-77
Authorized representative

T
R
W
9
CSE
1/4
1/4
1/4

Forward the white, blue and pink copies to the Department of Health and Environment

Form WWC-5