


1 LOCATION OF WATER WELL:	Fraction	Section Number	Township Number	Range Number
County: SHAWNEE	SE 1/4 SW 1/4 NE 1/4	24	T 11 S	R 14 E <del>XX</del>

Distance and direction from nearest town or city street address of well if located within city?  
 ONE AND 1/4 MILE SOUTH OF KAIRO KS., AND 1/4 MILE WEST

2 WATER WELL OWNER: HARLEY RENYER  
 RR#, St. Address, Box # : 1649 N.W. HUXMAN RD. Board of Agriculture, Division of Water Resources  
 City, State, ZIP Code : TOPEKA KS 66618 Application Number: 3618

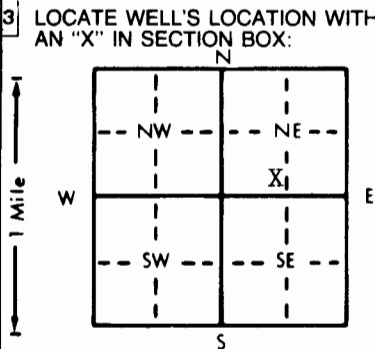

4 DEPTH OF COMPLETED WELL... 48 ft. ELEVATION: .....

Depth(s) Groundwater Encountered 1. 16 ft. 2. .... ft. 3. .... ft.

WELL'S STATIC WATER LEVEL ... 16 ft. below land surface measured on mo/day/yr 4-25-97

Pump test data: Well water was .29 ft. after .1 hours pumping .750 gpm  
 Est. Yield .800 gpm: Well water was .36 ft. after .2 hours pumping .800 gpm

Bore Hole Diameter: .32 in. to .48 ft., and ..... in. to ..... ft.

WELL WATER TO BE USED AS:

5 Public water supply	8 Air conditioning	11 Injection well
1 Domestic	3 Feedlot	6 Oil field water supply
2 Irrigation	4 Industrial	7 Lawn and garden only
		9 Dewatering
		12 Other (Specify below)
		10 Monitoring well

Was a chemical/bacteriological sample submitted to Department? Yes.....No. XX.....; If yes, mo/day/yr sample was sub-  
 mitted Water Well Disinfected? Yes No XX

5 TYPE OF BLANK CASING USED:

1 Steel	3 RMP (SR)	5 Wrought iron	8 Concrete tile	CASING JOINTS: Glued <u>X</u> Clamped <u>X</u>
2 PVC	4 ABS	6 Asbestos-Cement	9 Other (specify below)	Welded .....
		7 Fiberglass		Threaded.....

Blank casing diameter ... 16 in. to ... 28 ft., Dia ..... in. to ..... ft., Dia ..... in. to ..... ft.

Casing height above land surface ... 12 in., weight ..... lbs./ft. Wall thickness or gauge No. ... 50

TYPE OF SCREEN OR PERFORATION MATERIAL:

1 Steel	3 Stainless steel	5 Fiberglass	8 RMP (SR)	10 Asbestos-cement
2 Brass	4 Galvanized steel	6 Concrete tile	9 ABS	11 Other (specify) .....
				12 None used (open hole)

SCREEN OR PERFORATION OPENINGS ARE:

1 Continuous slot	3 Mill slot	5 Gauzed wrapped	8 Saw cut	11 None (open hole)
2 Louvered shutter	4 Key punched	6 Wire wrapped	9 Drilled holes	
		7 Torch cut	10 Other (specify) .....	

SCREEN-PERFORATED INTERVALS: From ... 28 ft. to ... 48 ft., From ..... ft. to ..... ft.

GRAVEL PACK INTERVALS: From ... 20 ft. to ... 48 ft., From ..... ft. to ..... ft.

6 GROUT MATERIAL: 1 Neat cement 2 Cement grout 3 Bentonite 4 Other .....

Grout Intervals: From ... 0 ft. to ... 20 ft., From ..... ft. to ..... ft., From ..... ft. to ..... ft.

What is the nearest source of possible contamination:

1 Septic tank	4 Lateral lines	7 Pit privy	10 Livestock pens	14 <u>Abandoned water well</u>
2 Sewer lines	5 Cess pool	8 Sewage lagoon	11 Fuel storage	15 Oil well/Gas well
3 Watertight sewer lines	6 Seepage pit	9 Feedyard	12 Fertilizer storage	16 Other (specify below)
			13 Insecticide storage	

Direction from well? NORTH How many feet? 10'

FROM	TO	LITHOLOGIC LOG	FROM	TO	PLUGGING INTERVALS
0	3	BROWN SANDY SILT			
3	6	FINE BROWN SAND			
6	23	BROWN & GREY SANDY CLAY			
23	28	MEDIUM BROWN GRAVEL			
28	32	SMALL-MEDIUM GREY SAND			
32	48	MEDIUM-LARGE GREY GRAVEL			
48		WEATHERED SHALE , STOPPED			

7 CONTRACTOR'S OR LANDOWNER'S CERTIFICATION: This water well was (1) constructed, (2) reconstructed, or (3) plugged under my jurisdiction and was completed on (mo/day/year) ... 4-26-97 ... and this record is true to the best of my knowledge and belief. Kansas Water Well Contractor's License No. ... 323. This Water Well Record was completed on (mo/day/yr) ... 5-6-97 under the business name of HOUBLER DRILLIG CO. by (signature) *[Signature]*

INSTRUCTIONS: Use typewriter or ball point pen. PLEASE PRESS FIRMLY and PRINT clearly. Please fill in blanks, underline or circle the correct answers. Send top three copies to Kansas Department of Health and Environment, Bureau of Water, Topeka, Kansas 66620-0001. Telephone: 913-296-5545. Send one to WATER WELL OWNER and retain one for your records.