


1	LOCATION OF WATER WELL:	Fraction	Section Number	Township Number	Range Number
	County: <u>SHAWNEE</u>	<u>SW 1/4 SW 1/4 SW 1/4</u>	<u>12</u>	<u>T 11 S</u>	<u>R 14 E</u>

Distance and direction from nearest town or city street address of well if located within city?  
@ 1/2 MILE NORTH OF HIGHWAY 24 ON HUMPHREY ROAD

2	WATER WELL OWNER: <u>SHAWNEE COUNTY CONSOLIDATED RWD No. 2</u> <u>RILEY REES, MANAGER</u>	WELL No. <u>1</u>
	RR #, St. Address, Box #: <u>2222 N.W. HUXMAN Rd</u> City, State, ZIP Code: <u>TOPEKA KANSAS 66618</u>	Board of Agriculture, Division of Water Resources Application Number:

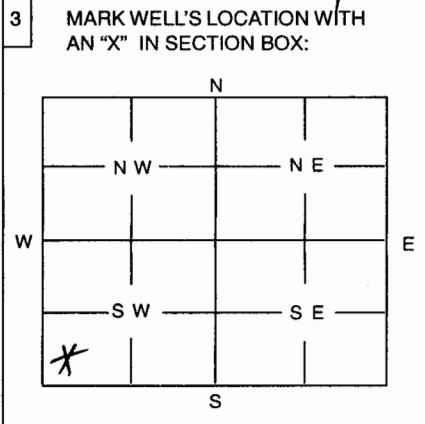

4	DEPTH OF WELL ..... <u>45</u> ..... ft												
	WELL'S STATIC WATER LEVEL ..... <u>20</u> ..... ft.												
	WELL WAS USED AS:												
	<table border="0"> <tr> <td>1 Domestic</td> <td><input checked="" type="radio"/> 5 Public Water Supply</td> <td>9 Dewatering</td> </tr> <tr> <td>2 Irrigation</td> <td>6 Oil Field Water Supply</td> <td>10 Monitoring Well</td> </tr> <tr> <td>3 Feedlot</td> <td>7 Domestic (Lawn &amp; Garden)</td> <td>11 Injection Well</td> </tr> <tr> <td>4 Industrial</td> <td>8 Air Conditioning</td> <td>12 Other .....</td> </tr> </table>	1 Domestic	<input checked="" type="radio"/> 5 Public Water Supply	9 Dewatering	2 Irrigation	6 Oil Field Water Supply	10 Monitoring Well	3 Feedlot	7 Domestic (Lawn & Garden)	11 Injection Well	4 Industrial	8 Air Conditioning	12 Other .....
1 Domestic	<input checked="" type="radio"/> 5 Public Water Supply	9 Dewatering											
2 Irrigation	6 Oil Field Water Supply	10 Monitoring Well											
3 Feedlot	7 Domestic (Lawn & Garden)	11 Injection Well											
4 Industrial	8 Air Conditioning	12 Other .....											
	Was a chemical / bacteriological sample submitted to Department? Yes ..... No <input checked="" type="checkbox"/> .....												
	If yes, mo/day/yr sample was submitted .....												
	Water Well Disinfected: Yes <input checked="" type="checkbox"/> ..... No .....												

5 TYPE OF BLANK CASING USED:

<input checked="" type="radio"/> 1 Steel	3 RMP (SR)	5 Wrought	7 Fiberglass	9 Other (Specify below)
2 PVC	4 ABS	6 Asbestos-Cement	8 Concrete Tile	

Blank casing diameter ..... 12 ..... in. Was casing pulled? Yes ..... No ..... If yes, how much .....

Casing height above or below land surface ..... 24 ..... in. CUT 4' BELOW GROUNDLEVEL - PITNESS

6 GROUT PLUG MATERIAL: 1 Neat cement 2 Cement grout  3 Bentonite  4 Other CHLORINATED SAND

Grout Plug Intervals:  From ..... 0 ..... ft. to ..... 4 ..... ft., From ..... 4 ..... ft. to ..... 20 ..... ft., From ..... 20 ..... to ..... 45 ..... ft.

NATIVE SOIL BENTONITE GROUT CHLORINATED SAND

What is the nearest source of possible contamination: N/A

1 Septic tank	6 Seepage pit	11 Fuel storage	16 Other (specify below)
2 Sewer lines	7 Pit privy	12 Fertilizer storage	
3 Watertight sewer lines	8 Sewage lagoon	13 Insecticide storage	
4 Lateral lines	9 Feedyard	14 Abandoned water well	
5 Cess Pool	10 Livestock pens	15 Oil well/Gas well	

Direction from well? ..... How many feet? .....

FROM	TO	PLUGGING MATERIALS
<u>0</u>	<u>4</u>	<u>NATIVE SOIL</u>
<u>4</u>	<u>20</u>	<u>BENTONITE GROUT</u>
<u>20</u>	<u>45</u>	<u>CHLORINATED SAND</u>

RECEIVED  
 NOV 03 2004  
 BUREAU OF WATER

7 CONTRACTOR'S OR LANDOWNER'S CERTIFICATION: This water well was plugged under my jurisdiction and was completed on (mo/day/year) OCTOBER 29, 2004 and this record is true to the best of my knowledge and belief. Kansas Water Well Contractor's License No. 581 This Water Well Record was completed on (mo/day/year) 10-29-04 under the business name of LAYNE CHRISTENSEN COMPANY by (signature) [Signature]

INSTRUCTIONS: Use typewriter or ball point pen. Please press firmly and print clearly. Please fill in blanks, underline or circle the correct answers. Send top three copies to Kansas Department of Health and Environment, Bureau of Water, Topeka, Kansas 66620-0001. Telephone: 785/296-3565. Send one to Water Well Owner and retain one for your records.