


1 LOCATION OF WATER WELL: Fraction SW 1/4 SW 1/4 SW 1/4 Section Number 12 Township Number T 11 S Range Number R 14 E
 County: SHAWNEE

Distance and direction from nearest town or city street address of well if located within city? 1/2 MILE NORTH OF HIGHWAY 24 ON HUMPHREY ROAD 30 FEET SOUTH AND 10 FEET WEST OF ORIGINAL WELL.

2 WATER WELL OWNER: SHAWNEE COUNTY CONSOLIDATED RURAL WATER DISTRICT NO. 2 (OFFSET NO. 1)
 RR#, St. Address, Box # RILEY REES, MANAGER
 City, State, ZIP Code 2222 N.W. HUXMAN ROAD TOPEKA, KANSAS 66618 Board of Agriculture, Division of Water Resources Application Number:

3 LOCATE WELL'S LOCATION WITH AN "X" IN SECTION BOX: 4 DEPTH OF COMPLETED WELL 51 ft. ELEVATION:

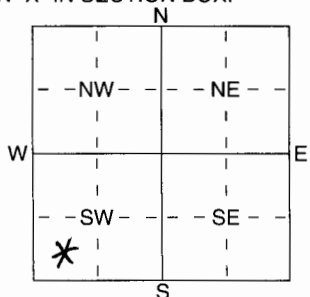

Depth(s) Groundwater Encountered 25.84 ft. 1 ft. 2 ft. 3 ft.
 WELL'S STATIC WATER LEVEL 25.84 ft. below land surface measured on mo/day/yr 10-13-04
 Pump test data: Well water was ft. after hours pumping gpm
 Est. Yield 450 gpm Well water was ft. after hours pumping gpm
 WELL WATER TO BE USED AS: Public water supply Air conditioning Injection well
 1 Domestic 3 Feedlot 6 Oil field water supply 9 Dewatering 12 Other (Specify below)
 2 Irrigation 4 Industrial 7 Domestic (lawn & garden) 10 Monitoring well
 Was a chemical/bacteriological sample submitted to Department? Yes No ; If yes, mo/day/yr sample was submitted
 Water Well Disinfected? Yes No

5 TYPE OF BLANK CASING USED: 1 Steel 2 PVC 3 RMP (SR) 4 ABS 5 Wrought iron 6 Asbestos-Cement 7 Fiberglass 8 Concrete tile 9 Other (specify below) 10" CERTI-LOK PVC CASING JOINTS: Glued Clamped Welded Threaded

Blank casing diameter 10 in. to 31 ft. Dia in. to ft. Dia in. to ft.
 Casing height above land surface 24 in., weight lbs./ft. Wall thickness or gauge No.

TYPE OF SCREEN OR PERFORATION MATERIAL: 1 Steel 2 Brass 3 Stainless Steel 4 Galvanized Steel 5 Fiberglass 6 Concrete tile 7 PVC 8 RMP (SR) 9 ABS 10 Asbestos-Cement 11 Other (Specify) 12 None used (open hole)
PITLESS UNIT

SCREEN OR PERFORATION OPENINGS ARE: 1 Continuous slot 2 Louvered shutter 3 Mill slot 4 Key punched 5 Guazed wrapped 6 Wire wrapped 7 Torch cut 8 Saw cut 9 Drilled holes 10 Other (specify) 11 None (open hole)

SCREEN-PERFORATED INTERVALS: From 31 ft. to 51 ft. From ft. to ft.
 GRAVEL PACK INTERVALS: From 20 ft. to 51 ft. From ft. to ft.

6 GROUT MATERIAL: 1 Neat cement 2 Cement grout 3 Bentonite 4 Other
 Grout Intervals: From 5 ft. to 20 ft. From 20 ft. to 20 ft. From 20 ft. to 20 ft. From ft. to ft.

What is the nearest source of possible contamination: N/A 10 Livestock pens 14 Abandoned water well
 1 Septic tank 4 Lateral lines 7 Pit privy 11 Fuel storage 15 Oil well/Gas well
 2 Sewer lines 5 Cess pool 8 Sewage lagoon 12 Fertilizer storage 16 Other (specify below)
 3 Watertight sewer lines 6 Seepage pit 9 Feedyard 13 Insecticide storage

FROM	TO	LITHOLOGIC LOG	FROM	TO	PLUGGING INTERVALS
0	2	TOP SOIL			
2	5	DARK BROWN SILTY CLAY			
5	8	DARK BROWN SILTY CLAY			
8	14.50	GRAY SILTY CLAY			
14.50	26	GRAY BROWN SILTY CLAY			
26	35	COARSE SAND w/ FINES / GRAVEL			
35	37	COARSE SAND / GRAVEL			
37	45	COARSE SAND / GRAVEL / FINES			
45	47	COARSE SAND / GRAVEL / CLAY			
47	48.50	COARSE SAND / GRAVEL / FINES			
48.50	51	COARSE SAND / GRAVEL / BOULDBERS			
51	52	GRAY SANDY SHALE			

7 CONTRACTOR'S OR LANDOWNER'S CERTIFICATION: This water well was (1) constructed, (2) reconstructed, or (3) plugged under my jurisdiction and was completed on (mo/day/year) OCTOBER 21, 2004 and this record is true to the best of my knowledge and belief. Kansas Water Well Contractor's Licence No 581 This Water Well Record was completed on (mo/day/yr) 10-29-04 under the business name of LAYNE CHRISTENSEN COMPANY by (signature) [Signature]