


1 LOCATION OF WATER WELL: County: Shawnee Fraction: NW 1/4 SW 1/4 SE 1/4 Section Number: 9 Township Number: T 11 S Range Number: R 14

Distance and direction from nearest town or city street address of well if located within city? 309 W. Railroad Street, Silver Lake, Kansas

2 WATER WELL OWNER: Kruger & Sons Auto Sales RR#, St. Address, Box #: 10019 Highway 24 City, State, ZIP Code: Silver Lake, Kansas 66539 Board of Agriculture, Division of Water Resources Application Number:

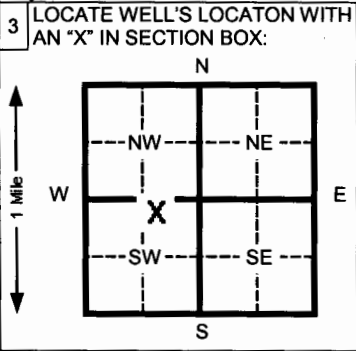

3 LOCATE WELL'S LOCATION WITH AN 'X' IN SECTION BOX: 4 DEPTH OF COMPLETED WELL: 33.0 ft. ELEVATION: 27.5 ft. WELL'S STATIC WATER LEVEL: 25.63 ft. below land surface measured on 03/14/07

5 TYPE OF BLANK CASING USED: 1 Steel 2 PVC 3 RMP (SR) 4 ABS 5 Wrought Iron 6 Asbestos-Cement 7 Fiberglass 8 Concrete tile 9 Other (specify below) CASING JOINTS: Glued Clamped Welded Threaded X

6 GROUT MATERIAL: 1 Neat cement 2 Cement grout 3 Bentonite 4 Other Grout Intervals: From 0.0 ft. to 1.5 ft. From 1.5 ft. to 16.0 ft. What is the nearest source of possible contamination: 10 Livestock pens 11 Fuel storage (former) 14 Abandoned water well 15 Oil well/ Gas well 16 Other (specify below)

LITHOLOGIC LOG table with columns: FROM, TO, CODE, and description of geological layers. Layers include Aggregate, Brown-red brown very silty clay, sandy, very firm, moist, Gray-brown very silty clay, sandy, very sandy 8-10', very firm, moist, Brown-gray clayey sand, very fine-medium grained, very silty, wet, Red-brown silty sand, medium-coarse grained, wet.

7 CONTRACTOR'S OR LANDOWNER'S CERTIFICATION: This water well was (1) constructed, (2) reconstructed, or (3) plugged under my jurisdiction and was completed on 03/14/07 and this record is true to the best of my knowledge and belief. Water Well Contractor's License No. 692 This Water Well Record was completed on 03/19/07 under the business name of Quad State Services, Inc. by (signature)

OFFICE USE ONLY T R SEC