WATER WELL RECORD Form WWC-5 KSA 82a-1212 ID No. _____

1 LOCATION OF WATER WELL:	Fraction	Section Number	Township Number	Range Number
County: Shawnee	NW ¼ NW ¼ NW ¼	17	T 11 S	R 14E E/W

Distance and direction from nearest town or city street address of well if located within city?
1¼ miles west & of Silver Lake

2 WATER WELL OWNER: Scott Bunker
RR#, St. Address, Box # : 3046 N. W. Docking Rd
City, State, ZIP Code : Silver Lake, Ks. 66539
Board of Agriculture, Division of Water Resources Application Number:

3 LOCATE WELL'S LOCATION WITH AN "X" IN SECTION BOX:

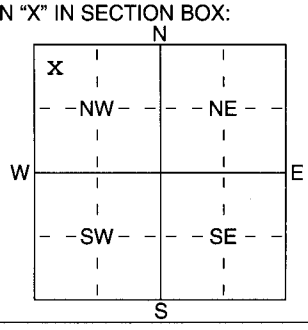

4 DEPTH OF COMPLETED WELL 52 ft. ELEVATION:
Depth(s) Groundwater Encountered 1 ft. 2 ft. 3 2-22-08 ft.
WELL'S STATIC WATER LEVEL 15 ft. below land surface measured on mo/day/yr
Pump test data: Well water was ft. after hours pumping gpm
Est. Yield 100 gpm: Well water was ft. after hours pumping gpm
WELL WATER TO BE USED AS: 1 Domestic 3 Feedlot 5 Public water supply 6 Oil field water supply 8 Air conditioning 9 Dewatering 11 Injection well 12 Other (Specify below)
2 Irrigation 4 Industrial 7 Domestic (lawn & garden) 10 Monitoring well
Was a chemical/bacteriological sample submitted to Department? Yes No x ; If yes, mo/day/yrs sample was submitted
Water Well Disinfected? Yes x No

5 TYPE OF BLANK CASING USED: 1 Steel 2 PVC 3 RMP (SR) 4 ABS 5 Wrought iron 6 Asbestos-Cement 7 Fiberglass 8 Concrete tile 9 Other (specify below)
CASING JOINTS: Glued x Clamped Welded Threaded
Blank casing diameter 5 in. to ft., Dia in. to ft., Dia in. to ft.
Casing height above land surface 24 in., weight ~2.82 lbs./ft. Wall thickness or guage No. .258

TYPE OF SCREEN OR PERFORATION MATERIAL: 1 Steel 2 Brass 3 Stainless Steel 4 Galvanized Steel 5 Fiberglass 6 Concrete tile 7 PVC 8 RMP (SR) 9 ABS 10 Asbestos-Cement 11 Other (Specify) 12 None used (open hole)

SCREEN OR PERFORATION OPENINGS ARE: 1 Continuous slot 2 Louvered shutter 3 Mill slot 4 Key punched 5 Guazed wrapped 6 Wire wrapped 7 Torch cut 8 Saw cut 9 Drilled holes 10 Other (specify) 11 None (open hole)

SCREEN-PERFORATED INTERVALS: From 41 ft. to 51 ft., From ft. to ft.
From ft. to ft., From ft. to ft.
GRAVEL PACK INTERVALS: From 25 ft. to 52 ft., From ft. to ft.
From ft. to ft., From ft. to ft.

6 GROUT MATERIAL: 1 Neat cement 2 Cement grout 3 Bentonite 4 Other
Grout Intervals: From 2 ft. to 25 ft., From ft. to ft., From ft. to ft.

What is the nearest source of possible contamination: 1 Septic tank 2 Sewer lines 3 Watertight sewer lines 4 Lateral lines 5 Cess pool 6 Seepage pit 7 Pit privy 8 Sewage lagoon 9 Feedyard 10 Livestock pens 11 Fuel storage 12 Fertilizer storage 13 Insecticide storage 14 Abandoned water well 15 Oil well/Gas well 16 Other (specify below)
Direction from well? west How many feet? 100

FROM	TO	LITHOLOGIC LOG	FROM	TO	PLUGGING INTERVALS
0	4	top soil			
4	9	brown clay			
9	15	very fine sand brown			
15	17	clay grey silty			
17	24	fine sand grey brown			
24	39	fine/course sand brown			
39	40	tan clay			
40	52	fine/course sand med pea brown			

7 CONTRACTOR'S OR LANDOWNER'S CERTIFICATION: This water well was (1) constructed, (2) reconstructed, or (3) plugged under my jurisdiction and was completed on (mo/day/year) 4-17-08 and this record is true to the best of my knowledge and belief. Kansas Water Well Contractor's Licence No 182 This Water Well Record was completed on (mo/day/yr) 4-17-08
under the business name of Strader Drilling co.Inc. by (signature)

INSTRUCTIONS: Use typewriter or ball point pen. *PLEASE PRESS FIRMLY* and *PRINT* clearly. Please fill in blanks, underline or circle the correct answers. Send top three copies to Kansas Department of Health and Environment, Bureau of Water, Geology Section, 1000 SW Jackson St., Suite 420, Topeka, Kansas 66612-1367. Telephone 785-296-5522. Send one to WATER WELL OWNER and retain one for your records. Fee of $5.00 for each constructed well.